


Give All Information Completely  
Make Required Affidavit  
Mail or Deliver Report to:  
Conservation Division  
State Corporation Commission  
212 No. Market  
Wichita, Kansas

WELL PLUGGING RECORD

Finney County, Sec. 18 Twp. 22S Rge. (E)34 (W)

Location as "NE/CNW/SW" or footage from lines. C SW SE  
Lease Owner Century Oil Company  
Lease Name Smith Well No. 1  
Office Address 925 Olive Garvey Bldg., Wichita, Kansas  
Character of Well (completed as Oil, Gas or Dry Hole) Dry Hole  
Date well completed December 30 1971  
Application for plugging filed December 30 1971  
Application for plugging approved December 30 1971  
Plugging commenced December 30 1971  
Plugging completed December 30 1971  
Reason for abandonment of well or producing formation

NORTH

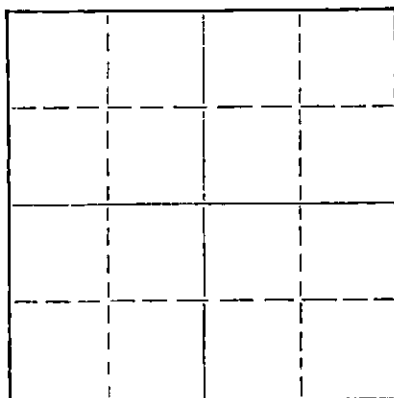

Locate well correctly on above  
Section Plat

If a producing well is abandoned, date of last production. 19  
Was permission obtained from the Conservation Division or its agents before plugging was commenced? Yes

Name of Conservation Agent who supervised plugging of this well  
Producing formation Depth to top Bottom Total Depth of Well 4800 Feet  
Show depth and thickness of all water, oil and gas formations.

OIL, GAS OR WATER RECORDS

CASING RECORD

FORMATION	CONTENT	FROM	TO	SIZE	PUT IN	PULLED OUT
				8 5/8"	509'	None

Describe in detail the manner in which the well was plugged, indicating where the mud fluid was placed and the method or methods used in introducing it into the hole. If cement or other plugs were used, state the character of same and depth placed, from feet to feet for each plug set.

Drilling Mud from 4800' to 500'  
Cement from 500' to 400' With 35 Sacks  
Drilling Mud from 400' to 40'  
Cement from 40' to Surface With 15 Sacks

RECEIVED  
STATE CORPORATION COMMISSION  
JAN 10 1972  
CONSERVATION DIVISION  
Wichita, Kansas


(If additional description is necessary, use BACK of this sheet)

Name of Plugging Contractor Earl F. Wakefield  
Address 300 West Douglas, Suite 500, Wichita, Kansas

STATE OF KANSAS, COUNTY OF SEDGWICK, ss.  
Gordon L. Koelling (employee of owner) or (owner or operator) of the above-described well, being first duly sworn on oath, says: That I have knowledge of the facts, statements, and matters herein contained and the log of the above-described well as filed and that the same are true and correct. So help me God.

(Signature) Gordon L. Koelling  
300 West Douglas, Suite 500, Wichita, Ks.  
(Address)

Subscribed and Sworn to before me this 4th day of January, 1972

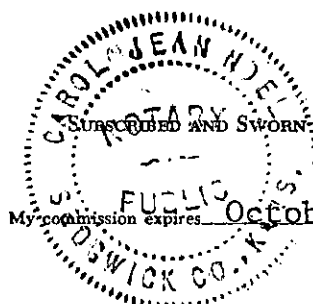

Carol Jean Noel  
Notary Public.

LEASE: SMITH #1  
 OWNER: CENTURY OIL COMPANY  
 CONT: EARL F. WAKEFIELD, INC.  
 COMM: 12-14-71  
 COMP: 12-30-71

LOCATION: C SW SE  
 SECTION 18-22S-34W  
 FINNEY COUNTY, KANSAS  
 CASING: 8 5/8" SET @ 509'

Surface Clay, Sand	230
Surface Clay, Sand & Shale	538
Shale	1470
Anhydrite	1510
Shale	2075
Shale - Lime	2410
Lime & Shale	2808
Lime	4800
R.T.D.	4800

RECEIVED  
 STATE CORPORATION COMMISSION  
 JAN 10 1972  
 CONSERVATION DIVISION  
 Wichita, Kansas

STATE OF KANSAS     )  
                           )  
 COUNTY OF SEDGWICK )     ss

I, Gordon L. Koelling, do hereby certify that this is a true and correct log on the Smith #1, located C SW SE of Section 18-22S-34W, Finney County, Kansas, as shown by the daily drilling reports.

EARL F. WAKEFIELD, INC.

BY *Gordon L. Koelling*  
 Gordon L. Koelling

Subscribed and sworn to before me this 4th Day of January, 1972.

My Commission Expires:  
October 22, 1972

*Carol Jean Noel*  
 Carol Jean Noel - Notary Public

