


Give All Information Completely
Make Required Affidavit
Mail or Deliver Report to:
Conservation Division
State Corporation Commission
800 Bittling Building
Wichita, Kansas

WELL PLUGGING RECORD

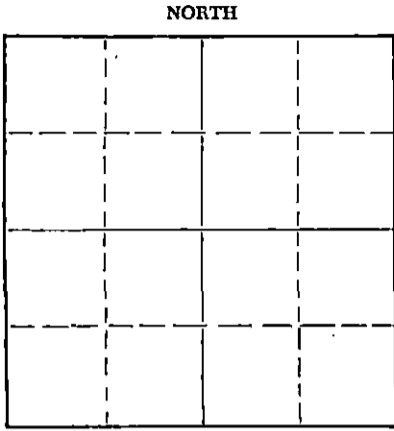

Locate well correctly on above Section Plat

Pawnee County. Sec. 8 Twp. 22 Rge. 16 (E)W. (W)
Location as "NE/CNW/SW" or footage from lines Cen. NE NE NE
Lease Owner Cities Service Oil Company
Lease Name Peterson "B" Well No. 1
Office Address Great Bend, Kansas
Character of Well (completed as Oil, Gas or Dry Hole) Dry Hole
Date well completed June 23 19 56
Application for plugging filed June 23 19 56
Application for plugging approved June 23 19 56
Plugging commenced June 23 19 56
Plugging completed June 23 19 56
Reason for abandonment of well or producing formation Dry Hole

If a producing well is abandoned, date of last production - 19
Was permission obtained from the Conservation Division or its agents before plugging was commenced? Yes

Name of Conservation Agent who supervised plugging of this well R. M. Brundege
Producing formation Arbuckle Depth to top 3895 Bottom 3905 Total Depth of Well 3905 Feet
Show depth and thickness of all water, oil and gas formations.

OIL, GAS OR WATER RECORDS

CASING RECORD

FORMATION	CONTENT	FROM	TO	SIZE	PUT IN	PULLED OUT
				8-5/8"	991'	None

Describe in detail the manner in which the well was plugged, indicating where the mud fluid was placed and the method or methods used in introducing it into the hole. If cement or other plugs were used, state the character of same and depth placed, from feet to feet for each plug set.

3905-300', mud.
300-230', 1/3 sack hulls, wood plug and 20 sacks cement.
230- 35', mud.
35' to base of cellar, 1/3 sack hulls, wood plug and 10 sacks cement.

(If additional description is necessary, use BACK of this sheet)

Name of Plugging Contractor Barbour Drilling Company
Address Tulsa, Oklahoma

STATE OF Kansas, COUNTY OF Barton, ss.
V. M. Conover (employee of owner) or (owner or operator) of the above-described well, being first duly sworn on oath, says: That I have knowledge of the facts, statements, and matters herein contained and the log of the above-described well as filed and that the same are true and correct. So help me God.

(Signature) V. M. Conover
Box 751, Great Bend, Kansas
(Address)

SUBSCRIBED AND SWORN TO before me this 26th day of June, 1956

W. G. Smith
Notary Public.

My commission expires March 12, 1959.

PLUGGING
FILE SEC. 8 T. 22 R. 16W
BOOK PAGE 74 LINE 2

STATE CORPORATION COMMISSION
JUN 27 1956
6-28-56
CONSERVATION DIVISION
WICHITA, KANSAS

WELL RECORD

Company Cities Service Oil Company Well No. 1 Farm Poterson "B"
 Location 330' South and 330' West of NE Corner Sec. 8 T. 22 R. 16W
 Elevation 2007 (2005 Gr.) County Fairlee State Kansas
 Drlg. Comm. June 9, 1956 Contractor Barbour Drilling Company
 Drlg. Comp. June 22, 1956 Acid None
 T. D. 3905' Initial Prod. Dry Hole - P. O. A. 6-23-56

CASING RECORD:

8-5/8" O 991' cas. 500 sk cement

FORMATION RECORD:

sand	0-110
clay & shale	305
shale & shells	440
sand	510
sand & shale	620
sand	635
sand, shells & shale	830
sand & red bed	982
anhydrite	1025
red bed, shale & shells	1790
shale, shells & lime	2005
lime & shale	2250
lime	2425
shale & lime	2655
lime	2690
lime & shale	2990
lime	3130
lime & shale	3215
lime	3315
lime & shale	3485
shale & lime	3520
lime	3730
lime & shale	3790
lime	3881
lime & chert	3889
lime	3905 T. D.

Heebner	3403'
Brown Limestone	3512'
Lansing	3519'
Dase Kansas City	3743'
Cherty Conglomerate	3858'
Erosional Arbuckle	3863'
Arbuckle	3895'
Penetration	10'
Total Depth	3905'

Drill Stem Test 3896-3905, open 1 hr., recovered 590' sulfur water; S. H. P. 1190#/30 mins.

SLOPE TESTS (SYFO):

500'	1°
1000'	0°
1500'	0°
2000'	0°
2500'	0°
3000'	1°
3500'	0°

RECEIVED

PLUGGING

FILE SEC 8 T 22 R 16W

BOOK PAGE 74 LINE 2