


STATE OF KANSAS
STATE CORPORATION COMMISSION

WELL PLUGGING RECORD

Give All Information Completely
Make Required Affidavit
Mail or Deliver Report to
Conservation Division
State Corporation Comm.
245 North Water
Wichita, KS 67202

Stafford County, Sec. 27 Twp. 22S Rge. 11W E/W
Location as "NE/CNW $\frac{1}{4}$ SW $\frac{1}{4}$ " or footage from lines
660' FWL; 990' FSL in NE $\frac{1}{4}$

Lease Owner Doskocil Sausage Company
Lease Name Morris #1 Well No. 1
Office Address 321 North Main Street, ^{South} Hutchinson, Kansas 67505
Character of Well (Completed as Oil, Gas or Dry Hole) Dry Hole

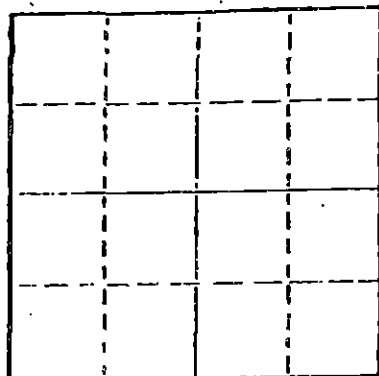

Locate well correctly on above
Section Plot

Date Well completed September 2, 1978 19
Application for plugging filed September 1, 1978 19
Application for plugging approved September 1, 1978 19
Plugging commenced 2:00 AM, September 2, 1978 19
Plugging completed 4:00 AM, September 2, 1978 19
Reason for abandonment of well or producing formation Dry Hole

If a producing well is abandoned, date of last production 19
Was permission obtained from the Conservation Division or
its agents before plugging was commenced? Yes

Name of Conservation Agent who supervised plugging of this well Bill Owens
Producing formation _____ Depth to top _____ Bottom _____ Total Depth of Well 3640'
Show depth and thickness of all water, oil and gas formations.

OIL, GAS OR WATER RECORDS

CASING RECORD

FORMATION	CONTENT	FROM	TO	SIZE	PUT IN	PULLED OUT
				8 5/8"	289'	None

Describe in detail the manner in which the well was plugged, indicating where the mud fluid was placed and the method or methods used in introducing it into the hold. If cement or other plugs were used, state the character of same and depth placed, from _____ feet to _____ feet for each plug set.

Filled hole with heavy mud.
50 sacks cement at 540'; 40 sacks at 300'.
Solid Bridge with 1/2 sack hulls and Howco
plug at 40' with 12 sacks cement. 3 sacks
cement in rathole.

(If additional description is necessary, use BACK of this sheet)

Name of Plugging Contractor Sterling Drilling Company
P. O. Box 129, Sterling, Kansas 67579

STATE OF KANSAS COUNTY OF RICE ss.
F. A. Wuellner (employee of owner) or (owner or operator) of the above-described well, being first duly sworn on oath, says: That I have knowledge of the facts, statements, and matters herein contained and the log of the above-described well as filed and that the same are true and correct. So help me God. **STERLING DRILLING COMPANY**

(Signature) F. A. Wuellner
F. A. Wuellner, Secretary
P. O. Box 129, Sterling, Kansas 67579
(Address)

Subscribed and sworn to before me this 5th day of September, 1978

My commission expires _____


Charles M. Hall
Charles M. Hall, Notary Public.

RECEIVED
STATE CORPORATION COMMISSION

SEP 18 1978

CONSERVATION DIVISION
Wichita, Kansas

STERLING DRILLING COMPANY
 P. O. Box 129
 Sterling, Kansas 67579

WELL LOG ----- MORRIS #1
 Located: 660' ETL; 990' EEL in NE/4, Sec. 27-22S-11W,
 Stafford County, Kansas

OWNER: Lockcoil Shusage Company
 ROTARY DRILLING CONTRACTOR: Sterling Drilling Company

COMMENCED: August 26, 1978
 COMPLETED: September 2, 1978

TOTAL DEPT : 3640'

<u>LYC</u>		<u>Casing Record</u>
0 -	264	Sand, Shale and Red Bed
264 -	292	Shale
292 -	415	Shale, Red Bed
415 -	1636	Shale
1636 -	2180	Shale and Lime
2180 -	2460	Lime
2460 -	2830	Lime and Shale
2830 -	3640	Lime.

Ran 7 joints 8 5/8" O.D. casing, tallied 277.39', set at 289' R.B. with 275 sacks Common with 2% gel and 3% cc. Plug-down at 6:00 PM, 8-26-78, by Allied.
 Plugged.

RECEIVED
 STATE CORPORATION COMMISSION
 SEP 18 1978
 CONSERVATION DIVISION
 Wichita, Kansas