


WELL PLUGGING RECORD

Give All Information Completely
Make Required Affidavit
Mail or Deliver Report to:
Conservation Division
State Corporation Commission
800 Bifling Building
Wichita, Kansas

NORTH

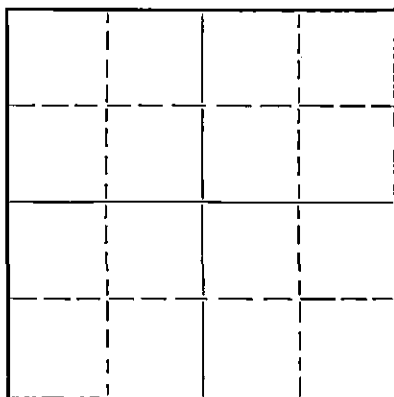

Locate well correctly on above
Section Plat

Stafford County. Sec. 27 Twp. 22 Rge. 11 (E) 11 (W)
Location as "NE/CNW $\frac{1}{4}$ SW $\frac{1}{4}$ " or footage from lines NW $\frac{1}{4}$ NW $\frac{1}{4}$ NE $\frac{1}{4}$
Lease Owner J. H. Tatlock
Lease Name Morris Well No. 1
Office Address 111 South Topeka, Wichita, Kansas
Character of Well (completed as Oil, Gas or Dry Hole) Dry Hole
Date well completed 2-22-51 19.
Application for plugging filed 2-22-51 19.
Application for plugging approved 2-22-51 19.
Plugging commenced 2-22-51 19.
Plugging completed 2-22-51 19.
Reason for abandonment of well or producing formation Dry Hole

If a producing well is abandoned, date of last production _____ 19.
Was permission obtained from the Conservation Division or its agents before plugging was commenced? Yes

Name of Conservation Agent who supervised plugging of this well Mr. Stough
Producing formation _____ Depth to top _____ Bottom _____ Total Depth of Well 3695 Feet
Show depth and thickness of all water, oil and gas formations.

OIL, GAS OR WATER RECORDS

CASING RECORD

Formation	Content	From	To	Size	Put In	Pulled Out
				8-5/8"	177'	None

Describe in detail the manner in which the well was plugged, indicating where the mud fluid was placed and the method or methods used in introducing it into the hole. If cement or other plugs were used, state the character of same and depth placed, from _____ feet to _____ feet for each plug set.

Hole filled with mud to 175'
Bottom plug pushed to 175'
25 SX cement on top
Hole filled to 30'
Top plug pushed to 30'
9 SX cement put on top of the plug
Filled to bottom of cellar

STATE CORPORATION COMMISSION
FEB 28 1951
CONSERVATION DIVISION
Wichita, Kansas

2-28-51

(If additional description is necessary, use BACK of this sheet)

Correspondence regarding this well should be addressed to Lewis Drilling Company
Address 607 Union National Bank Building, Wichita 2, Kansas

STATE OF KANSAS, COUNTY OF SEDGWICK, ss.
Hiram W. Lewis, Jr. (employee of owner) or (owner or operator) of the above-described well,
being first duly sworn on oath, says: That I have knowledge of the facts, statements, and matters herein contained and the log of the above-described well as filed and that the same are true and correct. So help me God.

(Signature) Hiram W. Lewis, Jr.
607 Union National Bank Building, Wichita 2, Kansas
(Address)

SUBSCRIBED AND SWORN to before me this 26th day of February 19 51
Arthur P. Sherrington
Notary Public.

My commission expires August 20, 1952.

PLUGGING
FILE SEC 27 T 22 R 11 W
BOOK PAGE 63 LINE 45

KANSAS WELL LOG BUREAU --- KANSAS GEOLOGICAL SOCIETY

508 EAST MURDOCK - WICHITA, KANSAS

COMPANY J. H. Tatlock

SEC. 27 T. 22 R. 11

FARM Morris

NO. 1

LOG.

NW $\frac{1}{4}$ NW $\frac{1}{4}$ NE $\frac{1}{4}$

TOTAL DEPTH 3695'

COMM. 2-9-51

COMP. 2-22-51


COUNTY Stafford

SHOT OR TREATED

CONTRACTOR Lewis Drilling Company

ISSUED

KANSAS

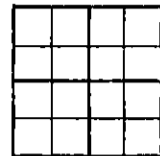

CASING

20 10
15 8-5/8" 177'
12 6
13 5

ELEVATION

PRODUCTION

FIGURES INDICATE BOTTOM OF FORMATIONS

- 0 - 120 Sand and red bed
- 120 - 130 Hard sand
- 130 - 540 Red bed
- 540 - 565 Anhydrite
- 565 - 1035 Red bed, shale and shells
- 1035 - 1440 Shale and shells
- 1440 - 1500 Shale and brown lime
- 1500 - 2355 Brown lime
- 2355 - 2520 Shale
- 2520 - 2624 Shale and brown lime
- 2624 - 2715 Shale
- 2715 - 2812 Shale and lime
- 2812 - 2935 Lime
- 2935 - 2960 Shale and lime
- 2960 - 3070 Lime
- 3070 - 3305 Lime and shale
- 3305 - 3510 Lime
- 3510 - 3565 Lime and shale
- 3565 - 3575 Lime
- 3575 - 3601 Conglomerate
- 3601 - 3625 Cherty Lime
- 3625 - 3684 Shale and sand
- 3684 - 3695 Lime
- 3695 - TD

RECEIVED
STATE CORPORATION COMMISSION
FEB 28 1951
CONSERVATION DIVISION
Wichita, Kansas

STATE OF KANSAS)
COUNTY OF SEDGWICK) SS.

Hiram W. Lewis, Jr., Lewis Drilling Company, of lawful age, being first duly sworn under oath, states that the Lewis Drilling Company was the Contractor engaged for the drilling of the Morris No. 1, located in the Northwest Quarter of the Northwest Quarter of the Northeast Quarter (NW $\frac{1}{4}$ NW $\frac{1}{4}$ NE $\frac{1}{4}$) of Section 27, Township 22 South, Range 11 West, Stafford County, Kansas, and that the foregoing log is a true and correct copy of the log of the completed well.

LEWIS DRILLING COMPANY

By Hiram W. Lewis, Jr.
Hiram W. Lewis, Jr.

Subscribed and sworn to before me, a Notary Public, in and for the county and state above mentioned, this 26th day of February, 1951.

Arthur B. Sherrington
Notary Public

My commission expires August 20, 1952.

PLUGGING
FILE SEC 27 T. 22 R. 11 W
BOOK PAGE 63 LINE 45