


STATE OF KANSAS  
STATE CORPORATION COMMISSION

Form CP-4

WELL PLUGGING RECORD

Give All Information Completely  
Make Required Affidavit  
Mail or Deliver Report to:  
Conservation Division  
State Corporation Commission  
212 No. Market  
Wichita, Kansas

NORTH

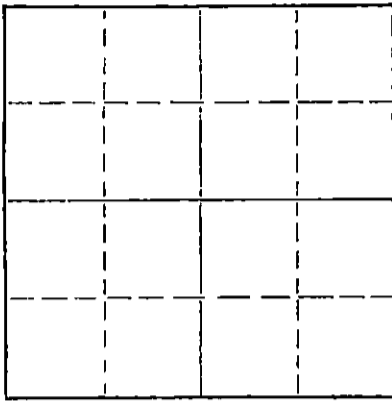

Locate well correctly on above  
Section Plat

Stafford County, Sec. 34 Twp. 22S Rge. 11 (E) (W) X

Location as "NE/CNW/SW" or footage from lines NE NW NE

Lease Owner Aspen Drilling Company

Lease Name Gates Well No. 1

Office Address P. O. Box 783 Great Bend, Kansas 67530

Character of Well (completed as Oil, Gas or Dry Hole)

Date well completed 19

Application for plugging filed 12-7-67 19

Application for plugging approved 12-8-67 19

Plugging commenced 12-16-67 19

Plugging completed 12-30-67 19

Reason for abandonment of well or producing formation

If a producing well is abandoned, date of last production 19

Was permission obtained from the Conservation Division or its agents before plugging was commenced? Yes

Name of Conservation Agent who supervised plugging of this well Archie V. Elving

Producing formation Depth to top Bottom Total Depth of Well 3623 Feet

Show depth and thickness of all water, oil and gas formations.

OIL, GAS OR WATER RECORDS

CASING RECORD

FORMATION	CONTENT	FROM	TO	SIZE	PUT IN	PULLED OUT
				8 5/8	20 1/2	None
				5 1/2	None	2971

Recd  
1-4-68  
JAN 4 1968

Describe in detail the manner in which the well was plugged, indicating where the mud fluid was placed and the method or methods used in introducing it into the hole. If cement or other plugs were used, state the character of same and depth placed, from feet to feet for each plug set.

Moved in. Cleaned out cellar. Sanded to 3600'. Dumped 5 sacks of cement.

Rigged up. Working pipe. Shot pipe at 2980'.

Circulating. Spotted 65 bbl of oil.

Working pipe. Pulling pipe.

Pushed plug to 200' rock bridge. Dumped 6 sacks of cement.

Bailing hole dry. Dumped 19 sacks of cement. Mud hole and rock bridge. Capped well with 10 sacks of cement.

(If additional description is necessary, use BACK of this sheet)

Name of Plugging Contractor Forbes Casing Pulling, Inc.  
Address P. O. Box 221 Great Bend, Kansas 67530

STATE OF Kansas, COUNTY OF Barton, ss.  
J. O. Forbes (employee of owner) or (owner or operator) of the above-described

well, being first duly sworn on oath, says: That I have knowledge of the facts, statements, and matters herein contained and the log of the above-described well as filed and that the same are true and correct. So help me God.

(Signature) J. O. Forbes  
P. O. Box 221 Great Bend, Kansas  
(Address)

SUBSCRIBED AND SWORN TO before me this 2 day of January, 1968

My commission expires May 27, 1969

(Signature)  
Notary Public.

DRILLERS LOG

#1 GATES

CASING RECORD:  
5 JTS 8-5/8"  
20# PIPE.

COMPANY: WESTERN PETROLEUM CO., INC.

DESCRIPTION: NE 1/4 NE  
SECTION 34-T22S-R11W  
STAFFORD CO., KANSAS

111 JTS 5 1/2"  
14# CASING.

CONTRACTOR: WESTERN PETROLEUM CO., INC.

COMMENCED: MAY 7, 1962  
ELEVATION: 1794 DF  
1797 KB

TOTAL DEPTH:  
3623' RTD

COMPLETED: MAY 19, 1962

FORMATION	FROM	TO	REMARKS
SHALE	0	15	SPUD 4:15 PM 5/7/62. RAN 5 JTS 8-5/8" 20# PIPE. (195.32'). SET AT 204' w/ 240 SXS 60x40 POZMIX. PLUG DOWN 9:30 PM 5/7/62.
SHALE AND SAND	15	103	
SAND	103	115	
SHALE	115	135	DST #1 3398 - 3435'. OP. 1 1/2 HRS. FAIR STEADY BLW. REC. 840' VISIBLE GAS, 180' OCCGM (OIL BLACK AND INERT) IBHP 1170#/30" FBHP 635#/30", IFP 50# FFP 5", HH 1905#
RED BED	135	305	
ANHYDRITE	305	525	DST #2 3530 - 3565'. OP. 1 1/4 HRS. GOOD TO FAIR BLW THROUGHOUT. REC. 1380' VISIBLE GAS, 60' GCIM w/ FEW OIL SPECKS. IBHP 230#/30", FBHP 215#/30" IFP 40#, FFP 50#, HH 1990#
RED BED	525	1000	
SHALE AND SHELLS	1000	1400	DST #3 3560 - 3605'. OP. 40". WEAK BLW 10". REC. 8' ROTARY MUD. NS IBHP 60#/30", FBHP 0#/30", IFP 0#, FFP 0#, HH 2000#
SHALE AND LIME	1400	1500	
LIME AND SHALE	1500	1910	DST #4 3618 - 23'. OP. 75". GOOD STEADY BLW THROUGHOUT. REC. 1080' VISIBLE GAS, 960' CLEAN OIL, 240' MUDDY OIL. NO APPARENT VTR., IBHP 1210#/30", FBHP 1210#/30", IFP 95#, FFP 425# HH 2010#
SHALE AND LIME	1910	2280	
LIME AND SHALE	2280	2940	RAN 111 JTS 5 1/2" 14# J-55 CASING (3620.15'). SET AT 3619' w/ 100 SXS 60x40 POZMIX SALT SATURATED CEMENT. PLUG DOWN 9:20 AM.
LIME	2940	3075	
SHALE AND LIME	3075	3220	
LIME	3220	3533	
LIME AND CHERT	3533	3565	
LIME	3565	3605	
SHALE	3605	3623	
RTD	3623		

DEC 13 1961  
CENTRAL DISTRICT DIVISION  
STAFFORD CO. KANSAS

ELECTRIC TOPS

ANHYDRITE	503	+1294	
HEEBNER	3053	-1256	
LANSING	3208	-1411	
B/KC	3456	-1659	
CONGLOMERATE	3502	-1705	
VIOLA	3530	-1733	
SIMPSON	3564	-1767	
ARBUCKLE	3618	-1821	

STATE OF KANSAS }  
COUNTY OF BARTON } ss

I, THE UNDERSIGNED, BEING DULY SWORN ON OATH, STATE THAT THE ABOVE STATEMENT AND LOG ARE TRUE AND A CORRECT RECORD AND LOG OF THE WELL DRILLED AT THE LOCATION ABOVE DESCRIBED.

WESTERN PETROLEUM CO., INC.

*F. L. Copeland*  
F. L. COPELAND, DRLG. SUPT.

SUBSCRIBED AND SWORN TO BEFORE ME THIS 21ST DAY OF MAY, 1962.

*Janice M. Becker*  
JANICE M. BECKER, NOTARY PUBLIC