


STATE OF KANSAS
STATE CORPORATION COMMISSION

Form CP-4

Give All Information Completely
Make Required Affidavit
Mail or Deliver Report to:
Conservation Division
State Corporation Commission
P. O. Box 17027
Wichita, Kansas 67217
NORTH

WELL PLUGGING RECORD

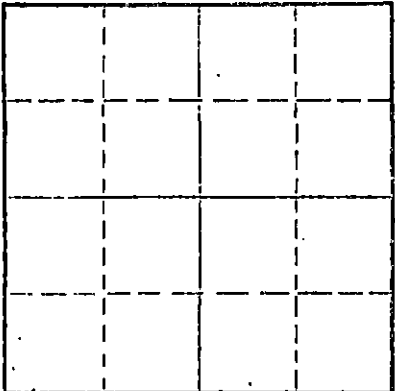

Locate well correctly on above
Section Plat

Stafford County, Sec 26 Twp 22 Rge 13 (E) (W)
Location as "NE/CNWSW" or footage from lines C NW SE SE
Lease Owner Chase Tank Service
Lease Name Spatz #2 Well No.
Office Address Chase, Kansas 67524
Character of Well (completed as Oil, Gas or Dry Hole)
Date well completed 19
Application for plugging filed 19
Application for plugging approved 19
Plugging commenced 4/30/73 19
Plugging completed 5/3/73 19
Reason for abandonment of well or producing formation depleted.
If a producing well is abandoned, date of last production 19
Was permission obtained from the Conservation Division or its agents before plugging was commenced? YES

Name of Conservation Agent who supervised plugging of this well Biberstein
Producing formation Depth to top Bottom Total Depth of Well 3760 Feet
Show depth and thickness of all water, oil and gas formations.

OIL, GAS OR WATER RECORDS

CASING RECORD

FORMATION	CONTENT	FROM	TO	SIZE	PUT IN	PULLED OUT
				8-5/8	280	none
				4 1/2"	3754	1388'

Describe in detail the manner in which the well was plugged, indicating where the mud fluid was placed and the method or methods used in introducing it into the hole. If cement or other plugs were used, state the character of same and depth placed, from feet to feet for each plug set.

Checked hole, ran sand to 3340' and dumped 4 sacks cement. Shot pipe at 3100', 2908', 2713', pipe parted, pulled 44 joints. Set rock bridge at 200' and dumped 3 yards ready mix.

PLUGGING COMPLETE.

RECEIVED
STATE CORPORATION COMMISSION
MAY 23 1973
CONSERVATION DIVISION
Wichita, Kansas


(If additional description is necessary, use BACK of this sheet)
Name of Plugging Contractor KELSO CASING PULLING
Address CHASE, KANSAS

STATE OF KANSAS, COUNTY OF RICE, SO.
R. DARRELL KELSO (employee of owner) or (owner or operator) of the above-described well, being first duly sworn on oath, says: That I have knowledge of the facts, statements, and matters herein contained and the log of the above-described well as filed and that the same are true and correct. So help me God.

(Signature) *R. Darrell Kelso*
CHASE, KANSAS (Address)

SUBSCRIBED AND SWORN TO before me this 7th day of May 1973

My commission expires

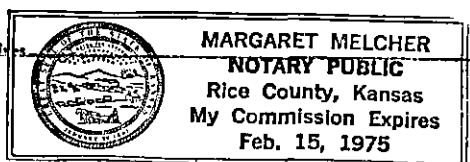

Margaret Melcher
Notary Public.

Brooks Pierce et al, Lease Owner

Section 26-22-13W

Donald T. Ingling, Contractor

Location: C NW SE SE

Commenced: 5-29-65
Completed: 6-8-65

County: Stafford

Total Depth: 3760' (rotary)

Production:

Elevation: 1887 RB

Casing: 8 5/8" 280' (250 sacks cement)
4 1/2" 3754' (125 sacks cement)

Figures below indicate bottom formation

- 40 surface clay
- 200 sand
- 280 red rock
- 710 shale and red rock
- 745 Anhydrite
- 1200 shale and shells
- 1640 shale and shells
- 1700 lime and shale
- 1830 lime and shale
- 1960 lime and shale
- 1975 lime and sand streaks
- 1990 sand and lime streaks
- 2010 lime
- 2160 lime and shale
- 2335 shale and lime
- 2515 lime and shale
- 2645 lime and shale
- 2850 shale and lime
- 3015 lime
- 3145 lime
- 3181 lime
- 3255 lime
- 3265 lime and shale
- 3368 shale and lime streaks
- 3380 lime
- 3425 lime
- 3465 lime
- 3530 lime
- 3581 lime
- 3640 lime and shale
- 3680 lime
- 3700 lime and chert
- 3715 shale and sand
- 3570 sand and shale
- 3760 lime - Arbuckle (3752)
- 3760 Total Depth

3728'

1750'

M-2921

RECEIVED
STATE CORPORATION COMMISSION
MAY 1 1973
CONSERVATION DIVISION
Wichita, Kansas

I certify this is a true and correct copy of the above mentioned well.

STATE OF KANSAS)
) ss.
SEDGWICK COUNTY)

Donald T. Ingling

Subscribed and sworn to before me, a Notary Public, in said county and state.

Commission expires: Feb. 27, 1968

M. Black
Notary Public