


STATE OF KANSAS  
STATE CORPORATION COMMISSION

Give All Information Completely  
Make Required Affidavit  
Mail or Deliver Report to:  
Conservation Division  
State Corporation Commission  
211 No. Broadway  
Wichita, Kansas

WELL PLUGGING RECORD

STAFFORD County. Sec. 28 Twp. 22s Rge. 13 (X) (W)  
NW SW NW

NORTH

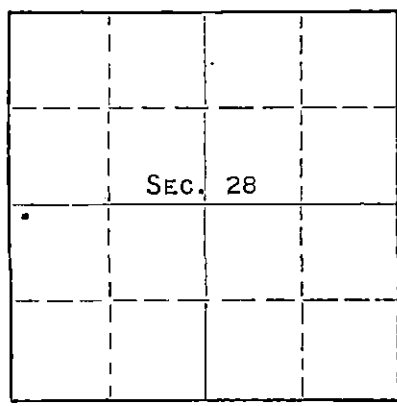

Locate well correctly on above Section Plat

Location as "NE/CNW&SW" or footage from lines \_\_\_\_\_  
Lease Owner PETROLEUM, INC.,  
Lease Name COSSMAN Well No. 1  
Office Address R.R. #2, GREAT BEND, KANSAS  
Character of Well (completed as Oil, Gas or Dry Hole) DRY HOLE  
Date well completed NOVEMBER 29 19 65  
Application for plugging filed NOVEMBER 29 19 65  
Application for plugging approved NOVEMBER 29 19 65  
Plugging commenced NOVEMBER 29 19 65  
Plugging completed NOVEMBER 29 19 65  
Reason for abandonment of well or producing formation NO PRODUCIBLE ZONE

If a producing well is abandoned, date of last production NONE 19  
Was permission obtained from the Conservation Division or its agents before plugging was commenced? YES

Name of Conservation Agent who supervised plugging of this well ARCHIE ELVING  
Producing formation \_\_\_\_\_ Depth to top \_\_\_\_\_ Bottom \_\_\_\_\_ Total Depth of Well 3522 Feet  
Show depth and thickness of all water, oil and gas formations.

OIL, GAS OR WATER RECORDS

CASING RECORD

FORMATION	CONTENT	FROM	TO	SIZE	PUT IN	PULLED OUT
				8-5/8"	303'	NONE

Describe in detail the manner in which the well was plugged, indicating where the mud fluid was placed and the method or methods used in introducing it into the hole. If cement or other plugs were used, state the character of same and depth placed, from \_\_\_\_\_ feet to \_\_\_\_\_ feet for each plug set.

MUDDED UP WITH HEAVY MUD TO 290', FOLLOWED BY WOODEN PLUG, PLACED 1/4 SACK HULLS AND 25 SACKS CEMENT ON TOP OF PLUG. MUDDED UP WITH MUD TO 40', FOLLOWED BY WOODEN PLUG, PLACED 1/2 SACK HULLS AND 13 SACKS CEMENT ON TOP OF PLUG TO BASE OF WELL CELLAR.

RECEIVED  
STATE CORPORATION COMMISSION

DEC -2 1965

CONSERVATION DIVISION  
WICHITA, KANSAS

12-2-65

(If additional description is necessary, use BACK of this sheet)

Name of Plugging Contractor GARVEY DRILLING COMPANY  
Address R.R. #2, GREAT BEND, KANSAS

STATE OF KANSAS, COUNTY OF BARTON, ss. MONTE CHADD (employee of owner) or (~~owner or operator~~) of the above-described well, being first duly sworn on oath, says: That I have knowledge of the facts, statements, and matters herein contained and the log of the above-described well as filed and that the same are true and correct. So help me God. MONTE CHADD, DIST. PROD. SPT.  
(Signature) \_\_\_\_\_

(Address)

SUBSCRIBED AND SWORN TO before me this 29 day of NOVEMBER, 19 65

My commission expires MAY 28, 1969

Richard H. Dunder  
Notary Public.

# WELL LOG

COMPANY Petroleum, Inc.

SEC. 28 T. 22S R. 13W

FARM Cossman

NO. 1

LOC. NW SW NW


TOTAL DEPTH 3522'

COUNTY Stafford

COMM. 11-22-65

COMP. 11-28-65

CONTRACTOR Garvey Drilling Company

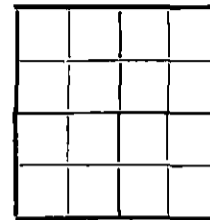

CASING 8 5/8" @ 303' w/250 sx

ELEVATION 1906' DF

PRODUCTION D & A

FIGURES INDICATE BOTTOM OF FORMATIONS

- 280' Clay and Sand
- 303' Red Bed
- 775' Red Bed and Shale
- 805' Anhydrite
- 1325' Shale
- 2205' Lime and Shale
- 3035' Shale and Lime
- 3320' Lime and Shale
- 3520' Shale and Lime
- 3522' Lime
- 3522' RTD

**RECEIVED**  
STATE CORPORATION COMMISSION

DEC -2 1965

CONSERVATION DIVISION  
Wichita, Kansas

State of Kansas }  
 County of Barton } SS

I, Sam N. Stephens of Garvey Drilling Company

upon oath state the above and foregoing is a true and correct copy of the log of the Cossman No. 1 well.

Sam N. Stephens

Subscribed and sworn to before me this 30th day of November 19 65.

My Commission Expires: November 5, 1969

Richard A. Doye  
NOTARY PUBLIC