

15.053.00020.00100

WELL PLUGGING RECORD

Give All Information Completely
Make Required Affidavit
Mail or Deliver Report to:
Conservation Division
State Corporation Commission
800 Bitting Building
Wichita, Kansas

Ellsworth

County, Sec. 7 Twp. 17S Rge. 10W (E) (W)

Location as "NE/CNW/SW" or footage from lines C W/2 NW NE

Lease Owner Drillers Production Company

Lease Name Frewert Well No. 2

Office Address 212 N. Market - Wichita, Kansas

Character of Well (completed as Oil, Gas or Dry Hole) Oil

Date well completed March 2 19 52

Application for plugging filed October 15 19 53

Application for plugging approved October 15 19 53


Plugging commenced October 17 19 53

Plugging completed October 22 19 53

Reason for abandonment of well or producing formation Depleted

If a producing well is abandoned, date of last production August 2 19 53

Was permission obtained from the Conservation Division or its agents before plugging was commenced? Yes

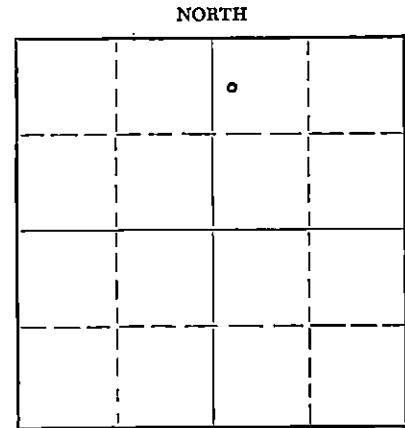

Locate well correctly on above Section Plat

Name of Conservation Agent who supervised plugging of this well Warren Horner

Producing formation Arbuckle Depth to top 3369 Bottom Total Depth of Well 3404 1/2 - / PB3396 Feet

Show depth and thickness of all water, oil and gas formations.

OIL, GAS OR WATER RECORDS

CASING RECORD

FORMATION	CONTENT	FROM	TO	SIZE	PUT IN	PULLED OUT
Arbuckle		3369	3396	8-5/8"	276'	None
				5-1/2"	3381 1/2'	2861.79'

Describe in detail the manner in which the well was plugged, indicating where the mud fluid was placed and the method or methods used in introducing it into the hole. If cement or other plugs were used, state the character of same and depth placed, from feet to feet for each plug set.

Filled hole with sand from 3396' to 3370'
and ran 6 sacks of cement. Mudded hole to 260',
bailed hole, set a 10' rock bridge to 250'
and ran 20 sacks of cement at 250'. Mudded
hole to 30' and ran 10 sacks of cement on
top. Plugging completed.

15-29-53

RELEASED
STATE CORPORATION COMMISSION
OCT 27 1953
CONFIDENTIAL

Name of Plugging Contractor West Supply Company - #14
Address Chase, Kansas

STATE OF Kansas, COUNTY OF Sedgwick, ss.

(employee of owner) or (owner or operator) of the above-described well, being first duly sworn on oath, says: That I have knowledge of the facts, statements, and matters herein contained and the log of the above-described well as filed and that the same are true and correct. So help me God.

(Signature) C. R. Bickford, Jr.
Insurance Bldg., 212 N. Market, Wichita, Kans.
(Address)

SUBSCRIBED AND SWORN to before me this October 27 day of October, 19 53

Bertha L. Wilson
Notary Public.

My commission expires August 13, 1955

PLUGGING
FILE SEC 7-17-10w
BOOK PAGE 136 LINE 4


15.053.00020.00.00
 WELL LOG BUREAU—KANSAS GEOLOGICAL SOCIETY
 508 East Murdock, Wichita, Kansas

Company THE CARL TODD DRILLING COMPANY ET AL
 Fa Frevert No. 2

SEC. 7 T. 17 R. 10W
 C W/2 NW NE

Total Depth. 3404
 Comm. 1-28-52 Comp. 2-8-52
 Shot or Treated.
 Contractor.
 Issued. 3-22-52

County Ellsworth
 KANSAS

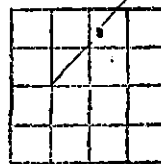

Elevation. 1914

Production. dry

8 5/8" 276' cem. w/190 sx
 5 1/2" 338 1/2' cem. w/75 sx

Figures Indicate Bottom of Formations.

post rock & clay	35
clay & shale	80
shale & shells	228
sand	238
shale & shells	490
redbed & shells	691
Anhydrite	717
shale & shells	1125
shale & salt	1235
shale & shells	1400
lime & shale	2100
broken lime	2190
shale & lime	2875
lime	3010
shale & lime	3045
lime	3320
lime & shale	3352
conglomerate	3360
cherty conglomerate	3364
shale cong.	3370
Arbuckle	3386, RTD
Arbuckle	3404
Total depth	

Tops: R. B.	
Topeka	2689
Heebner	2939
Toronto	2962
Base Oread	2973
Brown lime	3044
Lansing	3057
Conglomerate	3352
Shale conglomerate	3364
Arbuckle	3369
R. T.D.	3386

3369
 1914
 455

Remarks:

Drill s tem test 3093-3106, weak blow for 2 minutes, open 45 minutes, recovered 10' mud, with few spots oil, BHP zero in 15 minutes.
 Drill stem test 3373-06, weak steady blow, open 1 hour, rec. 35' oil cut mud with 1/2 gal free oil in tool. BHP 880# in 15 minutes.

RECEIVED
 STATE COMMISSION
 CONSERVATION DIVISION
 Wichita, Kansas

PLUGGING
 FILE SEC 7 T. 17 R. 10W
 BOOK PAGE 136 LINE 4