

15.053.00247.00.00  
WELL PLUGGING RECORD


STATE OF KANSAS  
STATE CORPORATION COMMISSION

Give All Information Completely  
Make Required Affidavit  
Mail or Deliver Report to:  
Conservation Division  
State Corporation Commission  
800 Bittling Building  
Wichita, Kansas

OR  
FORMATION PLUGGING RECORD

Strike out upper line  
when reporting plug-  
ging of formations.

NORTH

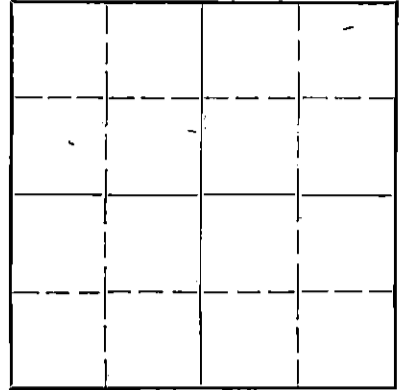

Locate well correctly on above  
Section Plot

Ellsworth County. Sec. 28 Twp. 15S. Rge. (E) 6 (W)  
Location as "NE1/4NW1/4SW1/4" or footage from lines... SW SW SE  
Lease Owner Bridgeport Oil Company, Inc.,  
Lease Name Webster "A" Well No. I  
Office Address 210 Schweiter Building - Wichita 2, Kansas  
Character of Well (completed as Oil, Gas or Dry Hole) Dry hole  
Date well completed 4 - 14 19 44  
Application for plugging filed 4 - 14 19 44  
Application for plugging approved 4 - 14 19 44  
Plugging commenced 4 - 14 19 44  
Plugging completed 4 - 14 19 44  
Reason for abandonment of well or producing formation Dry hole

If a producing well is abandoned, date of last production 19  
Was permission obtained from the Conservation Division or its agents before plugging was com-  
menced? Yes

Name of Conservation Agent who supervised plugging of this well Mr. Ruel Durkee  
Producing formation Depth to top Bottom Total Depth of Well 3392 Feet  
Show depth and thickness of all water, oil and gas formations.

OIL, GAS OR WATER RECORDS

CASING RECORD

Formation	Content	From	To	Size	Put In	Pulled Out
				8-5/8"	210'	None
					cemented with 135 sacks	

Describe in detail the manner in which the well was plugged, indicating where the mud fluid was placed and the method or methods used in introducing it into the hold. If cement or other plugs were used, state the character of same and depth placed, from feet to feet for each plug set.

Filled hole with mud from 3392' to 210'

Set plug at 210' with 15 sacks cement

Mud from 210' to 30'

Set plug at 30' and cemented on top of plug with 5 sacks to within 6' of top

PLUGGING  
FILE 28 15S 6W  
BOOK PAGE 14 LINE 17

4-22-44  
APR 22  
STATE OF KANSAS  
CORPORATION COMMISSION

(If additional description is necessary, use BACK of this sheet)

Correspondence regarding this well should be addressed to Bridgeport Oil Company, Inc.,  
Address 210 Schweiter Building - Wichita 2, Kansas.

STATE OF Kansas COUNTY OF Sedgwick ss.  
Frank Leach (employee of owner) or (owner or operator) of the above-described well,

being first duly sworn on oath, says: That I have knowledge of the facts, statements, and matters herein contained and the log of the above-described well as filed and that the same are true and correct. So help me God

(Signature) Frank Leach

Wichita, Kansas  
(Address)

SUBSCRIBED AND SWORN to before me this 21 day of April, 1944.

My commission expires Oct. 29, 1947  
My commission expires

Virginia Boyd  
Notary Public.

15.053.00247.00.00

BRIDGEPORT OIL COMPANY, Inc.,  
210 Schweiter Building,  
Wichita 2, Kansas.

Well Log-----Webster "A" #1  
SW SW SE 28-15S-6W  
Ellsworth County, Kansas

Elevation-----1668'  
Date Started-----3-18-44  
Date Completed---4-14-44

Casing Record:  
8-5/8" casing cemented @ 210'  
with 135 sacks bulk cement,

Rotary Tools-----0 to 3392'

LOG

0	210	Shale & Lime Shells
210	315	Shale & Shells
315	528	Red Bed
528	725	Shale & Shells
725	935	Salt & Shale
935	1005	Shale & Lime Shells
1005	1135	Shale & Lime
1135	1250	Lime (Broken)
1250	1325	Shale & Shells
1325	1450	Lime & Shale
1450	1565	Lime Broken
1565	1645	Lime & Shale
1645	1710	Shale & Lime Shells
1710	1960	Lime & Shale
1960	2075	Shale & Shells
2075	2200	Shale & Lime Shells
2200	2270	Shale & Lime
2270	2340	Shale & Lime Shells
2340	2410	Lime & Shale
2410	2465	Shale
2465	2508	Shale & Shells
2508	2603	Lime & Shale
2603	2710	Shale & Lime Shells
2710	2821	Lime & Shale
2821	2842	Shale
2842	2893	Lime Broken
2893	2921	Lime & Shale
2921	2962	Lime
2962	3030	Lime (Broken)
3030	3080	Lime & Shale
3080	3128	Shale & Lime Shells
3128	3170	Shale & Shells
3170	3204	Shale & Lime
3204	3300	Shale
3300	3345	Chert
3345	3392	Lime
3392		T. D.

Plugged & Abandoned 4-14-44

FORMATION TOPS - DF

Top Heebner	2583'
Top Toronto	2607'
Base Oread	2635'
Top Lansing	2757'
Top Mississippian	3296'
Base Mississippian	3370'

I, Frank Leach, do hereby certify that the above log is correct to the best of my knowledge and belief

BRIDGEPORT OIL COMPANY, INC.

By Frank Leach

**PLUGGING**  
FILE # 28-15S-6W  
BOOK PAGE 114 LINE 17

