


15.053.00231.00.01

WELL PLUGGING RECORD

Give All Information Completely
Make Required Affidavit
Mail or Deliver Report to:
Conservation Division
State Corporation Commission
212 North Market, Insurance Bldg.
Wichita, Kansas

Ellsworth County, Sec. 1 Twp. 17S Rge. 9W (W)
Location as "NE/CNW/SW" or footage from lines SE SE SE
Lease Owner Petroleum, Inc.
Lease Name Brown "Q" Well No. 1
Office Address Route 2, Great Bend, Kansas
Character of Well (completed as Oil, Gas or Dry Hole) Dry Hole
Date well completed August 7, 1959
Application for plugging filed August 17, 1959
Application for plugging approved August 21, 1959
Plugging commenced August 27, 1959
Plugging completed August 31, 1959
Reason for abandonment of well or producing formation No Producing Zones

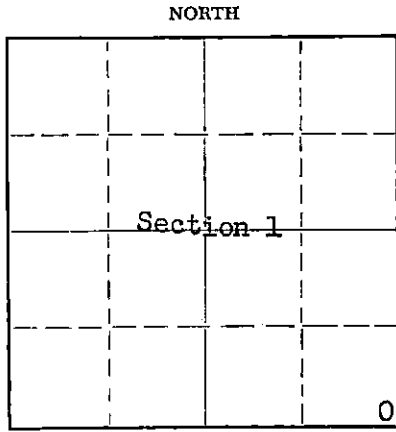

Locate well correctly on above Section Plat

If a producing well is abandoned, date of last production None 19
Was permission obtained from the Conservation Division or its agents before plugging was commenced? Yes

Name of Conservation Agent who supervised plugging of this well Gilbert J. Toman, Box 180, Holyrood, Kansas
Producing formation Depth to top Bottom Total Depth of Well 3315 Feet
Show depth and thickness of all water, oil and gas formations.

OIL, GAS OR WATER RECORDS

CASING RECORD

FORMATION	CONTENT	FROM	TO	SIZE	PUT IN	PULLED OUT
<u>Kansas City</u>	<u>Water and little oil</u>	<u>3036</u>	<u>3041</u>	<u>8-5/8"</u>	<u>225'</u>	<u>None</u>
	<u>n. a.</u>			<u>5-1/2"</u>	<u>3313'</u>	<u>2425'</u>

Describe in detail the manner in which the well was plugged, indicating where the mud fluid was placed and the method or methods used in introducing it into the hole. If cement or other plugs were used, state the character of same and depth placed, from feet to feet for each plug set.

(Plugged back to TD 3213')

Filled hole with crushed rock from 3213' to 3025' and placed 5 sacks cement on top of rock. Mudded up with heavy mud to 225' and made solid rock bridge, placed 20 sacks cement on top of rock bridge at 225'. Mudded up with heavy mud to 35' and made solid rock bridge. Filled hole to base of well cellar with 10 sacks cement.

9-2-59
STATE CORPORATION COMMISSION
SEP 2 1959
CONSERVATION DIVISION
Kansas

(If additional description is necessary, use BACK of this sheet)

Name of Plugging Contractor Morgan Well Plugging Service
Address 102 West 18th Street, Hutchinson, Kansas

STATE OF KANSAS, COUNTY OF BARTON, ss.
DON SEARLE (employee of owner) or (owner or operator) of the above-described well, being first duly sworn on oath, says: That I have knowledge of the facts, statements, and matters herein contained and the log of the above-described well as filed and that the same are true and correct. So help me God.

(Signature) Don Searle

Route 2, Great Bend, Kansas
(Address)

SUBSCRIBED AND SWORN to before me this 1st day of September, 1959

Arthur J. Wiles
Notary Public.

My commission expires April 14, 1963

PLUGGING
FILE SEC. 1 T. 17 R. 9W
BOOK PAGE 61 LINE 16