

15.053.00-125.00.00

WELL PLUGGING RECORD

Give All Information Completely
Make Required Affidavit
Mail or Deliver Report to:
Conservation Division
State Corporation Commission
211 No. Broadway
Wichita, Kansas

Ellsworth County, Sec. 15 Twp. 17S Rge. 7W ~~(24x200x15)~~

Location as "NE/CNW/SW" or footage from lines SW SW SW

Lease Owner L.A. Allison & Mayfield-Smith Drig., Inc.

Lease Name Carras-Fuller O.W.W.O. Well No. 1

Office Address 928 Union Center, Wichita, Kansas

Character of Well (completed as Oil, Gas or Dry Hole) D&A

Date well completed August 6, 1965

Application for plugging filed August 6 1965

Application for plugging approved August 6 1965

Plugging commenced August 6 1965


Plugging completed August 6 1965

Reason for abandonment of well or producing formation

Due to absence of commercial production

If a producing well is abandoned, date of last production - - - 19

Was permission obtained from the Conservation Division or its agents before plugging was commenced? Yes

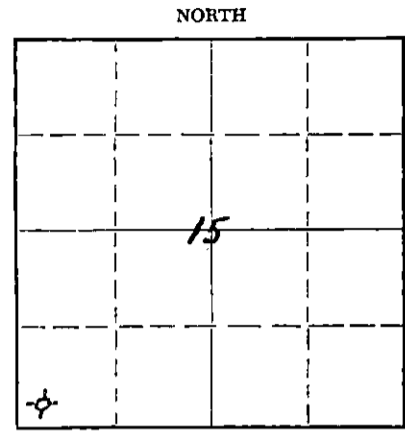

Locate well correctly on above Section Plat

Name of Conservation Agent who supervised plugging of this well Gilbert Toman

Producing formation - - Depth to top - - Bottom - - Total Depth of Well 3520 Feet

Show depth and thickness of all water, oil and gas formations.

OIL, GAS OR WATER RECORDS

CASING RECORD

FORMATION	CONTENT	FROM	TO	SIZE	PUT IN	PULLED OUT

Describe in detail the manner in which the well was plugged, indicating where the mud fluid was placed and the method or methods used in introducing it into the hole. If cement or other plugs were used, state the character of same and depth placed, from _____ feet to _____ feet for each plug set.

Filled hole with heavy rotary mud to 280'. Set bottom plug @ 280' W/25 Sk. Cement, 1/4 Sk. Hulls. Top plug @ 40' W/ 1/4 Sk. Hulls & cemented to base of cellar.

RECEIVED
STATE CORPORATION COMMISSION

AUG 11 1965

CONSERVATION DIVISION
Wichita, Kansas

8-11-65

(If additional description is necessary, use BACK of this sheet)

Name of Plugging Contractor Mayfield-Smith Drilling, Inc.

Address 928 Union Center, Wichita, Kansas

STATE OF Kansas, COUNTY OF Sedgwick, ss. Charles R. Mayfield

(employee of owner) or (owner or operator) of the above-described well, being first duly sworn on oath, says: That I have knowledge of the facts, statements, and matters herein contained and the log of the above-described well as filed and that the same are true and correct. So help me God.

(Signature) Charles R. Mayfield
928 Union Center, Wichita, Kansas
(Address)

Subscribed and Sworn to before me this 9th day of August, 1965

10-26-65

Marguerite Mayfield
Notary Public.

