


STATE OF KANSAS  
STATE CORPORATION COMMISSION

WELL PLUGGING RECORD

Give All Information Completely  
Make Required Affidavit  
Mail or Deliver Report to:  
Conservation Division  
State Corporation Commission  
800 Bittling Building  
Wichita, Kansas

NORTH

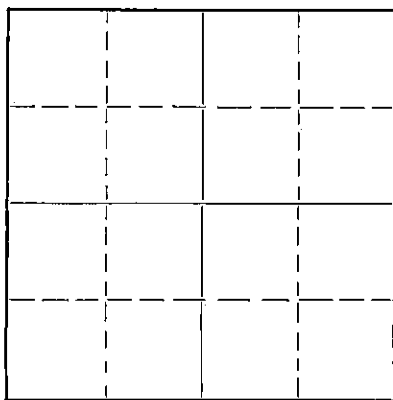

Locate well correctly on above  
Section Plat

Hodgeman County. Sec. 14 Twp. 22S Rge. (E) 24 (W)  
Location as "NE/CNW 1/4 SW 1/4" or footage from lines NE, NE, NE  
Lease Owner Jones, Shelburne & Farmer, Inc.  
Lease Name Shriwise Well No. 1  
Office Address Russell, Kansas  
Character of Well (completed as Oil, Gas or Dry Hole) Dry Hole  
Date well completed September 28 1950  
Application for plugging filed September 28 1950  
Application for plugging approved September 28 1950  
Plugging commenced September 28 1950  
Plugging completed September 28 1950  
Reason for abandonment of well or producing formation Dry

If a producing well is abandoned, date of last production Never Produced 19  
Was permission obtained from the Conservation Division or its agents before plugging was commenced? Yes

Name of Conservation Agent who supervised plugging of this well C. D. Stough  
Producing formation Depth to top Bottom Total Depth of Well 4735 Feet  
Show depth and thickness of all water, oil and gas formations.

OIL, GAS OR WATER RECORDS

CASING RECORD

Formation	Content	From	To	Size	Put In	Pulled Out
				8 5/8"	215'	None

Describe in detail the manner in which the well was plugged, indicating where the mud fluid was placed and the method or methods used in introducing it into the hole. If cement or other plugs were used, state the character of same and depth placed, from feet to feet for each plug set.

- Hole was filled with heavy mud.
- Halliburton plug pushed to 205 feet.
- Twenty sacks cement mixed and spotted on top of plug.
- Hole filled to top with heavy mud.
- Second Halliburton plug pushed to 30 feet.
- Fifteen sacks of cement mixed and dumped on top of second plug. 10-4-50

RECEIVED  
STATE CORPORATION COMMISSION  
OCT 4 - 1950  
CONSERVATION DIVISION  
Wichita, Kansas

(If additional description is necessary, use BACK of this sheet)

Correspondence regarding this well should be addressed to Jones, Shelburne & Farmer, Inc.  
Address Russell, Kansas

STATE OF Kansas, COUNTY OF Russell, ss.  
John O. Farmer (employee of owner) or (owner or operator) of the above-described well,  
being first duly sworn on oath, says: That I have knowledge of the facts, statements, and matters herein contained and the log of the above-described well as filed and that the same are true and correct. So help me God.

(Signature) *John O. Farmer*  
Russell, Kansas (Address)

SUBSCRIBED AND SWORN to before me this 29th day of September, 1950.  
*Dorleis Bethany* Notary Public.

My commission expires June 3, 1953  
PLUGGING  
FILE SEC 14 T 22S R15  
BOOK PAGE 31 LINE 38  
4-49-10M

# Jones, Shelburne & Farmer, Inc.

Russell, Kansas

## CONTRACTOR'S VERIFIED LOG

Operator JONES, SHELBURNE & FARMER, INC. Farm Name SHRIWISE Well No 1

Location NE NE NE SECTION 14-22S-24W

Pool Name \_\_\_\_\_ County HODGEMAN State KANSAS

Commencement Date 9/12/50 Completion Date 9/28/50

### Log of Well

Depth		Formation	Deviation from vertical (degrees)	Remarks
From	To			
0	210	Shale & sand		
210	1950	Shale & shells		
1950	2540	Shale & shells		
2540	2910	lime & shale		
2910	2990	lime		
2990	4115	lime & shale		
4115	4200	lime		
4200	4240	lime & shale		
4240	4420	lime		
4420	4460	lime & shale		
4460	4735	lime		
	4735	Total Depth		

RECEIVED  
 CORPORATION COMMISSION  
 OCT 4 - 1950  
 CONSERVATION DIVISION  
 Wichita, Kansas

PLUGGING  
 FILE SEC 14 T22 R 24W  
 BOOK PAGE 31 LINE 38

