


STATE OF KANSAS
STATE CORPORATION COMMISSION

WELL PLUGGING RECORD

Give All Information Completely
Make Required Affidavit
Mail or Deliver Report to
Conservation Division
State Corporation Comm.
245 North Water
Wichita, KS 67202

Hodgeman County. Sec. 13 Twp. 22S Rge. 24W EA
Location as "NE/CNW $\frac{1}{2}$ SW $\frac{1}{2}$ " or footage from lines
C-SE NW NE

Lease Owner E. K. Edmiston
Lease Name Salmans Well No. 1
Office Address 800 Vickers KSB&T Bldg., Wichita, KS
Character of Well (Completed as Oil, Gas or Dry Hole) 67202
Dry Hole

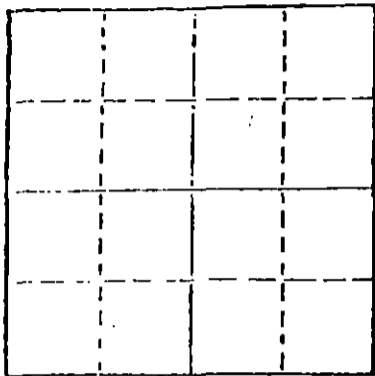

Locate well correctly on above
Section Plot

Date Well completed October 27, 1979
Application for plugging filed Verbal Application 1979
Application for plugging approved Verbal Approval 1979
Plugging commenced October 27, 1979
Plugging completed October 27, 1979
Reason for abandonment of well or producing formation _____

If a producing well is abandoned, date of last production _____ 1979

Was permission obtained from the Conservation Division or its agents before plugging was commenced? Yes

Name of Conservation Agent who supervised plugging of this well Clarence Thomas
Producing formation _____ Depth to top _____ Bottom _____ Total Depth of Well 4,750'
Show depth and thickness of all water, oil and gas formations.

OIL, GAS OR WATER RECORDS

CASING RECORD

FORMATION	CONTENT	FROM	TO	SIZE	PUT IN	PULLED OUT
				8-5/8"	316'	None

Describe in detail the manner in which the well was plugged, indicating where the mud fluid was placed and the method or methods used in introducing it into the hold. If cement or other plugs were used, state the character of same and depth placed, from _____ feet to _____ feet for each plug set.

Filled hole with heavy rotary mud from 4,750 ft. (rotary total depth) to 900 ft. Set plug at 900 ft. and cemented with 50 sacks cement. Filled hole with heavy rotary mud from 900 ft. to 300 ft. Set plug at 300 ft. and cemented with 35 sacks cement. Filled hole with heavy rotary mud from 300 ft. to 40 ft. Set solid plug at 40 ft. and cemented to cellar with 10 sacks cement, 5 sacks cement in rat hole.

Plugging operations accomplished utilizing Sun Oil Well cementing pump truck through 4 1/2 inch drill pipe.

(If additional description is necessary, use BACK of this sheet)

Name of Plugging Contractor Sun Oil Well Cementing, Inc.
Box 169, Great Bend, Kansas 67530

STATE OF Kansas COUNTY OF Sedgwick, ss.
Dean Britting, Agent (Notary Public of owner) ~~XXXXXXXXXXXXXXXXXXXX~~

of the above-described well, being first duly sworn on oath, says: That I have knowledge of the facts, statements, and matters herein contained and the log of the above-described well as filed and that the same are true and correct. So help me God.

(Signature) Dean Britting
200 N. Main, Wichita, Kansas 67202
(Address)

SUBSCRIBED AND SWORN TO before me this 1st day of November, 1979

My commission expires July 25, 1982

Elsie Willison
Notary Public.
STATE CORPORATION COMMISSION

NOV 02 1979

CONSERVATION DIVISION
Wichita, Kansas

11-2-79

KANSAS DRILLERS LOG

COMPANY E. K. Edmiston

SEC. 13 T. 22S R. 24W
 LOC. C-SE NW NE

FARM Salmans NO. 1

COUNTY Hodgeman

ROTARY TOTAL DEPTH 4,750'
 COMM. October 15, 1979 COMP. October 27, 1979
 CONTRACTOR H-30, INC. (Rig #2)
 ISSUED November 1, 1979

CASING

10 3/4"
 8 5/8" Set at 316' cemented w/185 sxs cement
 5 1/2"
 4 1/2"

ELEVATION 2,423' K.E.

FIGURES INDICATE BOTTOM OF FORMATIONS

Sand and Shale	230'
Shale	320'
Shale and Sand	820'
Shale	1,175'
Sand	1,410'
Shale and Red Bed	1,688'
Anhydrite	1,735'
Shale and Lime	1,929'
Shale	2,030'
Shale and Lime	2,805'
Lime and Shale	2,925'
Lime	3,100'
Shale and Lime	3,250'
Lime	3,390'
Lime and Shale	4,205'
Lime	4,750'
Rotary Total Depth	4,750'

I hereby certify the above and foregoing to be a true and correct log of the above described well as shown by the drilling reports.

H-30, INC.

Dean Britting

 Dean Britting

State of Kansas }
 County of Sedgwick } ss:

Subscribed and Sworn to before me a Notary Public in and for said county and state this 1st day of November, 1979.



Elsie Willison

 Elsie Willison Notary Public
 STATE COMMISSION COMMISSIONER

My Commission Expires:
 July 25, 1982

NOV 02 1979

CONSERVATION DIVISION
 Wichita, Kansas