


WELL PLUGGING RECORD

Give All Information Completely
Make Required Affidavit
Mail or Deliver Report to:
Conservation Division
State Corporation Commission
800 Bitting Building
Wichita, Kansas

NORTH

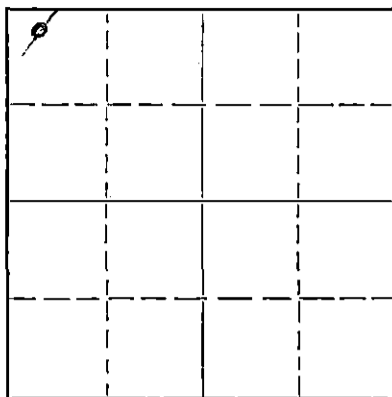

Locate well correctly on above
Section Plat

NW NW NW Hodgeman County. Sec. 18 Twp. 22S Rge. 25W (E) (W)
Location as "NE/CNW $\frac{1}{4}$ /SW $\frac{1}{4}$ " or footage from lines 380' East & 330' South NW corner
Lease Owner Texoma Production Company
Lease Name Frank Nilhas Well No. 1
Office Address Box 2211, Amarillo, Texas
Character of Well (completed as Oil, Gas or Dry Hole) Dry Hole
Date well completed June 3 1952
Application for plugging filed June 3 1952
Application for plugging approved June 3 1952
Plugging commenced June 4 1952
Plugging completed June 4 1952
Reason for abandonment of well or producing formation Dry

If a producing well is abandoned, date of last production _____ 19____
Was permission obtained from the Conservation Division or its agents before plugging was commenced? yes

Name of Conservation Agent who supervised plugging of this well W. A. Rives
Producing formation none Depth to top _____ Bottom _____ Total Depth of Well 5,243 Feet
Show depth and thickness of all water, oil and gas formations.

OIL, GAS OR WATER RECORDS

CASING RECORD

Formation	Content	From	To	Size	Put In	Pulled Out

Describe in detail the manner in which the well was plugged, indicating where the mud fluid was placed and the method or methods used in introducing it into the hole. If cement or other plugs were used, state the character of same and depth placed, from _____ feet to _____ feet for each plug set.

Set 8 5/8 Halliburton at 420' ran 30' of common cement through drill pipe
Plug back to 298' capped with 8 5/8" inside protectors with steel plate
welled on top
Hole filled with mud on top of cement.

6-13-52
RECEIVED
STATE CORPORATION COMMISSION
JUN 13 1952
CONSERVATION DIVISION
Wichita, Kansas

(If additional description is necessary, use BACK of this sheet)
Name of Plugging Contractor J. R. McGill
Address Amarillo Building, Amarillo, Texas

STATE OF Texas, COUNTY OF Potter, ss.
Hart P. Kyle (employee of owner) or (owner or operator) of the above-described well,
being first duly sworn on oath, says: That I have knowledge of the facts, statements, and matters herein contained and the log of the above-described well as filed and that the same are true and correct. So help me God.

(Signature) Hart P. Kyle
Box 275 Dumas Texas
(Address)

SUBSCRIBED AND SWORN TO before me this 6th day of JUNE, 1952
Dorothy M. Curphy
Notary Public.

My commission expires 1953

23-8390-3 6-51-20M
PLUGGING
FILE SEC-18T-2R-264
BOOK PAGE 21 LINE 30

DRILLERS LOG

COMPANY: Texoma Production Company SEC. 18 T. 22-N R. 25-W
 NW NW NW
 FARM: F. Nilhas No. 1 COUNTY: Hodgeman, Kansas
 Total Depth. 5243'
 Comm. 5-3-52 Comp. 6-4-52
 CASING:
 8-5/8" 585' Cem. Production. Dry

Figures indicate Bottom of Formations

Surface soil & sand	0-90
Sand	150
Shale	815
Red Beds & Shale	1080
Gypsum	1125
Shale & shells	1520
Shale & gypsum	1944
Shale & shells	2070
Anhydrite & shale	2310
Anhydrite & lime	2437
Anhydrite & shale	2705
Dolomite & chert	2751
Dolomite & lime	2812
Lime	3072
Lime & shale	3582
Lime	4168
Lime & shale	4233
Lime	4265
Lime & shale	4292
Lime	4366
Lime & shale	4380
Lime	4430
Lime & shale	4465
Lime	4541
Lime & shale	4651
Cherty lime	4680
Lime	4963
Lime & shale	5015
Lime	5077
Lime & chert	5104
Lime	5243
Total Depth	5243

RECEIVED
 STATE CORPORATION COMMISSION

JUN 13 1952

CONSERVATION DIVISION
 Wichita, Kansas

I, Charles I. Galloup, being first duly sworn on oath, state that I have knowledge of the facts and matter herein set forth and that the same are true and correct.

Name Charles I. Galloup Title Field Supt.

Subscribed and sworn to before me this 9th day of June, 1952

Notary Public Potter County, Texas

Patsy E. Parton
 Address Box 2211, Amarillo, Texas

