


STATE OF KANSAS
STATE CORPORATION COMMISSION

WELL PLUGGING RECORD

Give All Information Completely
Make Required Affidavit
Mail or Deliver Report to
Conservation Division
State Corporation Comm.
245 North Water
Wichita, KS 67202

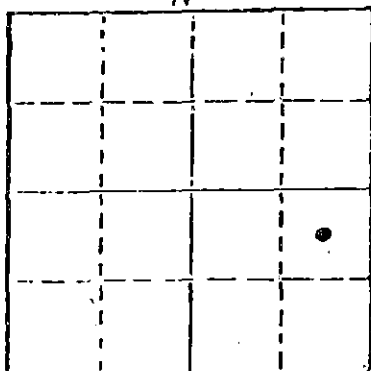

Locate well correctly on above
Section Plot

Finney Co. County, Sec. 1 Twp. 22S Rge. 30W E/W
Location as "NE/CNW $\frac{1}{4}$ SW $\frac{1}{4}$ " or footage from lines

C. NE SE
Lease Owner Mull Drilling Co., Inc.
Lease Name Byrd # 1 Well No. 1
Office Address 221 North Main Suite 300; Wichita, KS 67202
Character of Well (Completed as Oil, Gas or Dry Hole)

DRY HOLE
Date Well completed 3-6-81 19
Application for plugging filed March 6, 1981
Application for plugging approved March 6, 1981
Plugging commenced March 6, 1981
Plugging completed March 6, 1981
Reason for abandonment of well or producing formation

DRY HOLE
If a producing well is abandoned, date of last production 19

Was permission obtained from the Conservation Division or
its agents before plugging was commenced? YES

Name of Conservation Agent who supervised plugging of this well Clarence Thomas Jr.
Producing formation Depth to top Bottom Total Depth of Well
Show depth and thickness of all water, oil and gas formations.

OIL, GAS OR WATER RECORDS

CASING RECORD

FORMATION	CONTENT	FROM	TO	SIZE	PUT IN	PULLED OUT
Surface Casing		0	334'	8 5/8		0

Describe in detail the manner in which the well was plugged, indicating where the mud fluid was placed and the method or methods used in introducing it into the hold. If cement or other plugs were used, state the character of same and depth placed, from feet to feet for each plug set.

Bottom plug set at 360' with 60 Sacks 50 - 50 Poz 6% Gel

Solid Bridge at 40' with 10 Sacks " " "

5 Sacks in Rathole

5 Sacks in Mouse hole Plug down at 1:00AM 3-6-81 Halliburton Cementing Co.

(If additional description is necessary, use BACK of this sheet)

Name of Plugging Contractor Blue Goose Drilling Co., Inc.

STATE OF KANSAS COUNTY OF BARTON, ss.
George E. Miller, Jr. (employee of owner) or (owner or operator)
of the above-described well, being first duly sworn on oath, says: That I have knowledge of the facts, statements, and matters herein contained and the log of the above-described well as filed and that the same are true and correct. So help me God.


(Signature)

P.O. Box 1413; Great Bend, KS 67530
(Address)

SUBSCRIBED AND SWORN TO before me this 6th day of March, 1981

Helen C. Standley
Notary Public.

My commission expires 12-8-83

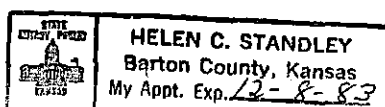

RECEIVED
3-12-81
MAR 12 1981

CONSERVATION DIVISION
Wichita, Kansas

WELL LOG

BYRD # 1
C NE SE Sec 1-22S-30W
Finney County, Kansas

NAME OF OPERATOR: Mull Drilling Co., Inc.
221 North Main Suite 300
Wichita, KS 67202


DATE COMPLETED: March 6, 1981

<u>FROM</u>	<u>TO</u>	
0	1775	Sand and Shale
1775	2185	Shale - Anhydrite
2185	2745	Sand and Shale, Iron Pyrite
2745	3710	Shale and Lime
3710	3871	Sand and Shale
3871	3990	Shale and Lime
3990	4150	Sand and Shale
4150	4570	Shale and Lime
4570	4585	Sand and Shale
4585	4605	Lime and Shale
4605	4675	Shale
4675	4700	Shale and Lime
4700		T.D.


STATE OF KANSAS


COUNTY OF BARTON ss

George E. Miller, Jr., President of Blue Goose Drilling Co., Inc. being first duly sworn on oath says: That I have knowledge of the facts, statements and matters herein contained and the log of the above described well as filed and that the same are true and correct.

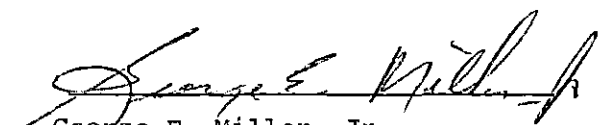
George E. Miller, Jr.

Subscribed and sworn before me this 10th Day of March 1981

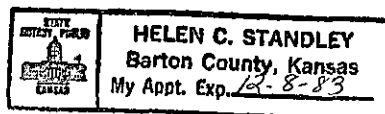

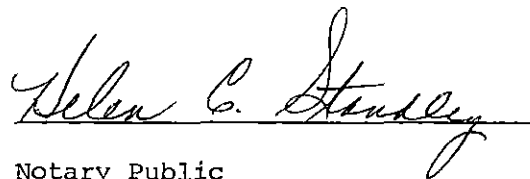

Notary Public

My Commission Expires: 12-8-83

RECEIVED
STATE CORPORATION COMMISSION

MAR 12 1981

CONSERVATION DIVISION
Wichita, Kansas