


WELL PLUGGING RECORD

Give All Information Completely
Make Required Affidavit
Mail or Deliver Report to:
Conservation Division
State Corporation Commission
800 Bittling Building
Wichita, Kansas

Stafford County. Sec. 36 Twp. 22 Rgd. 2 (E) (W)

Location as "NE/CNW $\frac{1}{4}$ SW $\frac{1}{4}$ " or footage from lines NW SW NW
Lease Owner E. H. Adair
Lease Name Hayes Well No. 1
Office Address 407 W-K-H Bldg. Wichita, Kansas
Character of Well (completed as Oil, Gas or Dry Hole) barren dry hole
Date well completed 8-2-53 19
Application for plugging filed 8-2-53 19
Application for plugging approved 8-2-53 19
Plugging commenced 8-2-53 19
Plugging completed 8-2-53 19
Reason for abandonment of well or producing formation barren

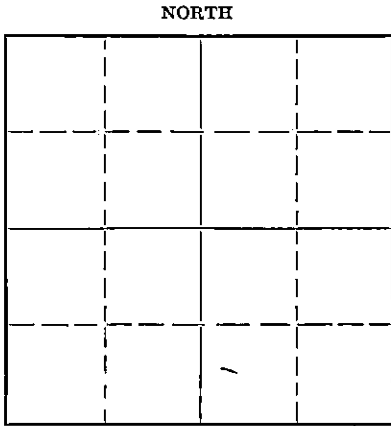

Locate well correctly on above Section Plat

If a producing well is abandoned, date of last production 19
Was permission obtained from the Conservation Division or its agents before plugging was commenced? Yes

Name of Conservation Agent who supervised plugging of this well M.A. Rives, Pratt Kansas
Producing formation Depth to top Bottom Total Depth of Well 3701 Feet
Show depth and thickness of all water, oil and gas formations.

OIL, GAS OR WATER RECORDS

CASING RECORD

Formation	Content	From	To	Size	Put In	Pulled Out

Describe in detail the manner in which the well was plugged, indicating where the mud fluid was placed and the method or methods used in introducing it into the hole. If cement or other plugs were used, state the character of same and depth placed, from feet to feet for each plug set.

Placed plug at 220' put 20 sacks cement on plug filled hole with mud up to 35 feet of surface. Placed plug at 35' filled hole up to surface with 100 sacks.

8-12-53

(If additional description is necessary, use BACK of this sheet)

Name of Plugging Contractor E.H. Adair Oil Company
Address 407 W-K-H Building


STATE OF Kansas COUNTY OF Sedgwick, ss.
Kenneth W. Johnson (employee of owner) or (owner or operator) of the above-described well,

being first duly sworn on oath, says: That I have knowledge of the facts, statements, and matters herein contained and the log of the above-described well as filed and that the same are true and correct. So help me God.

(Signature) Kenneth W. Johnson
Wichita, Kansas (Address)

SUBSCRIBED AND SWORN to before me this 10th day of August, 1953

My commission expires 9-15-53 Notary Public.

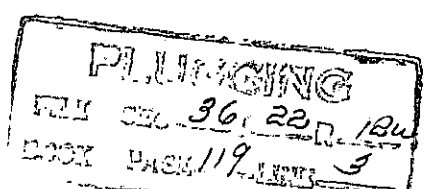

L-O-G

E. H. Adair Oil Company

NW-SW-NW

Hayes # 1

Stafford County

Commenced: 7-22-53

T.D. 3701

Completed: 8-2-53

Elevation 1830 K.B.

FIGURES INDICATE BOTTOM OF FORMATION

Shale	30
Sand	100
Sand	140
Shale & Shells	223
Shale & Shells	375
Anhydrite	590
Shale	88 5
Shale & Shells	1355
Shale & Shells	1500
Lime & Shale	1525
Lime	1557
Lime	1674
Lime	1690
Lime & Shale	1775
Lime	1837
Lime & Shale	1892
Shale & Shells	2000
Shale & Shells	2025
Lime	2130
Lime	2180
Shale & Shells	229 0
Shale & Shells	2439
Shale & Shells	2579
Shale & Shells	2658
Shale & Shells	2810
Shale & Shells	2830
Lime	2901
Lime	2910
Shale	2950
Lime	3023
Lime	3116
Lime	3202
Shale	3270
Lime	3284
Lime	3327
Lime	3387
Lime	3420
Lime	3427
Lime	3473
Lime	3515
Lime & Shale	3562
Shale & Lime	3571
Arbuckle	3589
Lime	3598
Lime	3630
Lime	3669
Lime	3679
Lime	3701

TOPS

Anhydrite	575
Ft. Riley	1500
Heebner	3104-1274
Brown Lime	3241-1411
Lansing K.C.	3268-1438
Simpson	3549-1719
Arbuckle	3576-1746

T.D.

PLUGGING

STAMPED
 1953

CERTIFIED CORRECT

Kenneth W. Johnson
 Kenneth W. Johnson