


WELL PLUGGING RECORD

Give All Information Completely
Make Required Affidavit
Mail or Deliver Report to:
Conservation Division
State Corporation Commission
800 Bitting Building
Wichita, Kansas

Stafford County. Sec. 36 Twp. 22 Rge. 12 (E) (W)
SW SW SW

Location as "NE/CNW/SW" or footage from lines _____
Lease Owner E. H. Adair Oil Co.
Lease Name Hayes Well No. 2
Office Address Wheeler-Kelly-Hagny Bldg., Wichita, Kansas
Character of Well (completed as Oil, Gas or Dry Hole) Dry Hole
Date well completed 9-25 19 53
Application for plugging filed 9-25 19 53
Application for plugging approved 9-25 19 53
Plugging commenced 9-25 19 53
Plugging completed 9-25 19 53
Reason for abandonment of well or producing formation Dry

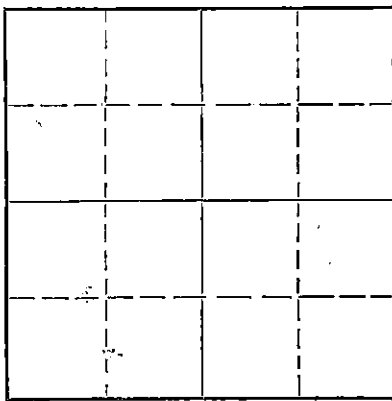

Locate well correctly on above Section Plat

If a producing well is abandoned, date of last production _____ 19____
Was permission obtained from the Conservation Division or its agents before plugging was commenced? Yes

Name of Conservation Agent who supervised plugging of this well M. A. Rives
Producing formation _____ Depth to top _____ Bottom _____ Total Depth of Well 3755 Feet
Show depth and thickness of all water, oil and gas formations.

OIL, GAS OR WATER RECORDS

CASING RECORD

FORMATION	CONTENT	FROM	TO	SIZE	PUT IN	PULLED OUT
				8-5/8"	250'	-----

Describe in detail the manner in which the well was plugged, indicating where the mud fluid was placed and the method or methods used in introducing it into the hole. If cement or other plugs were used, state the character of same and depth placed, from _____ feet to _____ feet for each plug set.

Top plug set at 40' with 10 sacks cement
Bottom plug set at 240' with 20 sacks cement

10-6-53

(If additional description is necessary, use BACK of this sheet)
Name of Plugging Contractor Anschutz Drilling Company
Address Union Nat'l Bank Bldg., Wichita, Kansas


STATE OF KANSAS, COUNTY OF SEDGWICK, ss. E. G. Koelling employee of contractor
(employee of owner) or (owner or operator) of the above-described well, being first duly sworn on oath, says: That I have knowledge of the facts, statements, and matters herein contained and the log of the above-described well as filed and that the same are true and correct. So help me God.

(Signature) E. G. Koelling
Union Nat'l Bank Bldg., Wichita, Kansas
(Address)

SUBSCRIBED AND SWORN TO before me this 28th day of September, 19 53

My commission expires May 2, 1956

Josephine Harrison
Notary Public.

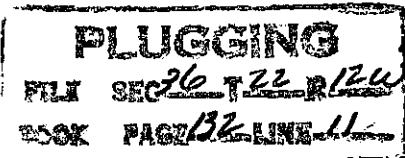

DRILLER'S LOG

E. H. Adair Oil Company
 #2 Hayes
 SW SW SW - 36-22S-12W
 Stafford County, Kansas

<u>FROM</u>	<u>TO</u>	
0	145	Sand
145	250	Red bed & shells
250	565	Red bed
565	585	Anhydrite
585	670	Shale
670	1250	Shale & shells
1250	1370	Shale & salt
1370	1465	Shale & shells
1465	1990	Lime
1990	2150	Lime & shale
2150	2300	Lime broken
2300	3045	Shale & lime
3045	3113	Lime
3113	3295	Shale & lime
3295	3558	Lime
3558	3600	Conglomerate (cherty)
3600	3615	Chert
3615	3640	Chert
3640	3680	Cherty lime
3680	3718	Arbuckle
3718	3755	Dolomite (cherty)

COMMENCED: 9-12-53
 COMPLETED: 9-25-53

CASING RECORD

Set 8-5/8" surface casing at 250'
 with 225 sacks cement.

STATE OF KANSAS)
) SS
 COUNTY OF SEDGWICK)

I hereby affirm that the above and foregoing is a true and correct copy of the log of the #2 Hayes located SW SW SW Section 36-22S-12W, Stafford County, Kansas.

ANSCHUTZ DRILLING COMPANY

BY: *E. G. Koelling*
 E. G. Koelling

Subscribed and sworn to before me this 29th day of September, 1953.

My Commission Expires: May 2, 1956

Josephine...
 Notary Public

PLUGGING
 FILE SEC 36 T 22 R 12W
 BOOK PAGE 132 LINE 11

