

STATE OF KANSAS
STATE CORPORATION COMMISSION


WELL PLUGGING RECORD

Give All Information Completely
Make Required Affidavit
Mail or Deliver Report to:
Conservation Division
State Corporation Commission
211 No. Broadway
Wichita, Kansas

Stafford County, Sec. 33 Twp. 22 Rge. 12 (X) W (W)

Location as "NE/CNW/SW" or footage from lines SE SE NW
Lease Owner Leo G. Wetherill, Jr.
Lease Name SPANGENBERG Well No. 1
Office Address 2208 Power & Light Bldg., Kansas City 5, Mo.
Character of Well (completed as Oil, Gas or Dry Hole) Dry Hole
Date well completed April 21 19 65
Application for plugging filed " 19 65
Application for plugging approved " 19 65
Plugging commenced April 22 19 65
Plugging completed " 19 65
Reason for abandonment of well or producing formation _____

NORTH

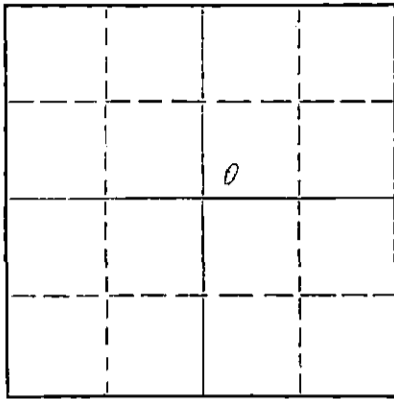

Locate well correctly on above
Section Plat

If a producing well is abandoned, date of last production 19____
Was permission obtained from the Conservation Division or its agents before plugging was commenced? yes

Name of Conservation Agent who supervised plugging of this well Archie Elving
Producing formation _____ Depth to top _____ Bottom _____ Total Depth of Well 3700 Feet
Show depth and thickness of all water, oil and gas formations.

OIL, GAS OR WATER RECORDS

CASING RECORD

FORMATION	CONTENT	FROM	TO	SIZE	PUT IN	PULLED OUT

Describe in detail the manner in which the well was plugged, indicating where the mud fluid was placed and the method or methods used in introducing it into the hole. If cement or other plugs were used, state the character of same and depth placed, from _____ feet to _____ feet for each plug set.

Filled hole with heavy mud to 215',
Set plug. 1/3 sack hulls & 25 sacks cement
Filled hole with heavy mud to 40'
Set plug. 1/3 sack hulls & 10 sacks cement.
Plugged rat hole

RECEIVED
STATE CORPORATION COMMISSION

APR 26 1965

CONSERVATION DIVISION
Wichita, Kansas

(If additional description is necessary, use BACK of this sheet)

Name of Plugging Contractor _____
Address _____

STATE OF KANSAS, COUNTY OF BARTON, ss.
L. O. Chubb (employee of owner) or (owner) of the above-described well, being first duly sworn on oath, says: That I have knowledge of the facts, statements, and matters herein contained and the log of the above-described well as filed and that the same are true and correct. So help me God.

(Signature) L. O. Chubb
Box 823, Great Bend, Kansas
(Address)

SUBSCRIBED AND SWORN TO before me this 22nd day of April, 19 65.

My commission expires June 24, 1967 Clair E. Stimson Notary Public.



W E L L L O G

DATE COMMENCED: April 13, 1965
 DATE COMPLETED: April 21, 1965

Leo G. Wetherill, Jr.
 SPANGENBERG #1
 SE/4 SE/4 NW/4
 Sec. 33-22-12W
 Stafford County, Kansas

0	-	108'	Sand
108	-	155'	Shale - Sand
155	-	631'	Red Bed
631	-	650'	ANHYDRITE
650	-	1556'	Shale & Red Bed
1556	-	2070'	Lime & Shale
2070	-	22335'	Shale
22335	-	2810'	Lime - Shale
2810	-	2900'	Shale - Lime
2900	-	3137'	Lime
3137	-	3142'	Shale
3142	-	3169'	Lime-Shale
3169	-	3268'	Shale
3268	-	3292'	Lime - Shale
3292	-	3568'	Lime
3568	-	3682'	Shale Chert
3682	-	3700'	Dolomite

ELEVATION: 1845 K.B.

FORMATIONS

ANHYDRITE	631
HEBBNER	3137
IATAN	3268
LANSING	3298
CONGLOMERATE	3558
ARBUCKLE	3682
RTD	3700

SURFACE PIPE: Set 8-5/8" casing, 28#, at 238' with 225 sacks cement by Sun

RECEIVED
 STATE CORPORATION COMMISSION

APR 26 1965

CONSERVATION DIVISION
 Wichita, Kansas

AFFIDAVIT


STATE OF KANSAS
 COUNTY OF BARTON) ss.

L. O. Chubb, of lawful age, does swear that the facts and statements herein contained are true and correct to the best of his knowledge.


 L. O. Chubb

Subscribed and sworn to before me this 23rd day of April, 1965.

MY COMMISSION EXPIRES:
 6-24-67


 Clair E. Stinson-NOTARY PUBLIC