

STATE OF KANSAS  
STATE CORPORATION COMMISSION

WELL PLUGGING RECORD

FORMATION PLUGGING RECORD

Give All Information Completely  
Make Required Affidavit  
Make and Deliver Report to:  
Conservation Division  
State Corporation Commission  
800 Bittling Building  
Wichita, Kansas

Strike out upper line  
when reporting plugging  
of formations.

Stafford County. Sec. 33 Twp. 22S Rge. 12W (E) (W)

Location as "NE 1/4 NW 1/4 SW 1/4" or footage from lines NE 1/4 NE 1/4 NW 1/4

Lease Owner Birmingham-Bartlett Drilling Co.

Lease Name Spangenberg Well No. 1

Office Address 300 Kaufman Building, Wichita, Kansas

Character of Well (completed as Oil, Gas or Dry Hole) Dry Hole

Date well completed March 1 19 50

Application for plugging filed (verbal) March 1 19 50

Application for plugging approved (verbal) March 1 19 50


Plugging commenced March 3 19 50

Plugging completed March 7 19 50

Reason for abandonment of well or producing formation Dry hole

If a producing well is abandoned, date of last production None 19

Was permission obtained from the Conservation Division or its agents before plugging was commenced? Yes

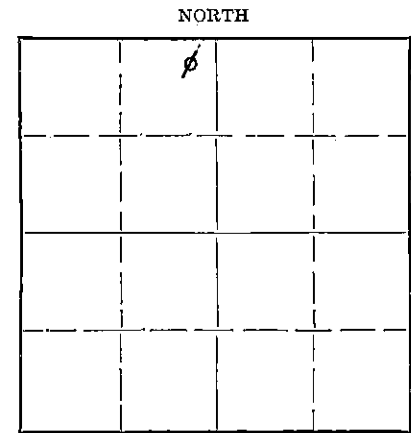

Locate well correctly on above  
Section Plat

Name of Conservation Agent who supervised plugging of this well C. D. Stough

Producing formation Arbuckle lime Depth to top 3703' Bottom 3732' Total Depth of Well 3732' Feet

Show depth and thickness of all water, oil and gas formations.

OIL, GAS OR WATER RECORDS

CASING RECORD

Formation	Content	From	To	Size	Put In	Pulled Out
				8-5/8"	243'	None
				5-1/2"	3705'	3137'

Describe in detail the manner in which the well was plugged, indicating where the mud fluid was placed and the method or methods used in introducing it into the hole. If cement or other plugs were used, state the character of same and depth placed, from \_\_\_\_\_ feet to \_\_\_\_\_ feet for each plug set.

Plugged back from total depth of 3732' up to 3700' with crushed rock; then dumped 5 sacks of cement on top of rock; then mudded hole from 3660' up to 245' where a rock bridge was set and 15 sacks of cement was dumped on top; then hole was filled with mud from 205' up to base of 30'; then filled surface casing to top of hole in the base of cellar with 10 sacks of cement.

(If additional description is necessary, use BACK of this sheet)

Correspondence regarding this well should be addressed to Birmingham-Bartlett Drilling Co.  
Address 300 Kaufman Building, Wichita 2, Kansas

STATE OF KANSAS, COUNTY OF SEDGWICK, ss.

Richard Hindery, partner of owner, of the above-described well, being first duly sworn on oath, says: That I have knowledge of the facts, statements, and matters herein contained and the log of the above-described well as filed and that the same are true and correct. So help me God.

(Signature) Richard Hindery

300 Kaufman Building, Wichita, Kansas  
(Address)

SUBSCRIBED AND SWORN to before me this 8th day of March 19 50

Notary Public. [Signature]

My commission expires November 29, 1950

PLUGGING 22-2625  
FILE SEC 33 T 22 R 12W  
BOOK PAGE 141 LINE 31

2-48-15M

STATE CORPORATION  
COMMISSION  
KANSAS

3-10-50

SPANGENBERG NO. 1

location: NE $\frac{1}{4}$  NE $\frac{1}{4}$  NW $\frac{1}{4}$  Sec. 33-22S-12W  
Stafford County, Kansas

OPERATOR: Birmingham-Bartlett Drilling Co.

CONTRACTOR: Birmingham-Bartlett Drilling Co.

SURFACE CASING: Ran 8 jts., 246.64' 8-5/8" 28# new casing  
cemented @ 243' with 150 sacks cement and 2 cc.

OIL STRING: Ran 106 jts., 3718' 5 $\frac{1}{2}$ " J-55 casing cemented  
@ 3705' with 75 sacks cement.

SPUDDED: 2-10-50  
COMPLETED: 2-24-50

L O G

(Figures indicate bottom of formation)

0	5to	450	Sand and shale	
		600	Red Bed	
		650	Shale and shells	
		670	Anhydrite	
		1565	Shale and shells	
		2044	Lime	
		2300	Lime and shale	
		2425	Shale and shells and lime	
	*	2680	Shale	* 2545 shale and shells
		2820	Shale and shells	
		2900	Broken lime and shale	
		2970	Broken lime	
		3285	Lime	
		3355	Lime and shale	
		3585	Lime	
		3635	Viola Chert	
		3650	Simpson shale	
		3708	Lime and shale	
		3708	Total Depth.	

The undersigned Richard Hindery of the Birmingham-Bartlett Drilling Co. hereby certifies that the above is a true and correct log of the formations encountered in drilling the No. 1 Spangenberg as shown on the daily drilling reports.

BIRMINGHAM-BARTLETT DRILLING CO.

BY

*Richard Hindery*

Subscribed and sworn before me  
this 27th day of February, 1950.

*Vivian J. Zenger*  
Notary Public

My commission expires November 29, 1950.

PLUGGING  
FILE SEC. 33 T. 22 R. 12W  
BOOK PAGE 141 LINE 31