

STATE OF KANSAS
STATE CORPORATION COMMISSION

WELL PLUGGING RECORD

Give All Information Completely
Make Required Affidavit
Mail or Deliver Report to:
Conservation Division
State Corporation Commission
800 Bittling Building
Wichita, Kansas

Stafford County, Sec. 33 Twp. 22S Rge. 12W (E) (W)

Location as "NE/CNW/SW" or footage from lines NW NW SE

Lease Owner Birmingham-Bartlett Drilling Company

Lease Name Krankenbergl Well No. 1

Office Address Wichita, Kansas

Character of Well (completed as Oil, Gas or Dry Hole) Dry Hole

Date well completed May 12 19 52

Application for plugging filed August 18 19 52

Application for plugging approved August 20 19 52


Plugging commenced 8-28-52 19 52

Plugging completed 8-31-52 19 52

Reason for abandonment of well or producing formation _____

If a producing well is abandoned, date of last production _____ 19 _____

Was permission obtained from the Conservation Division or its agents before plugging was commenced? Yes

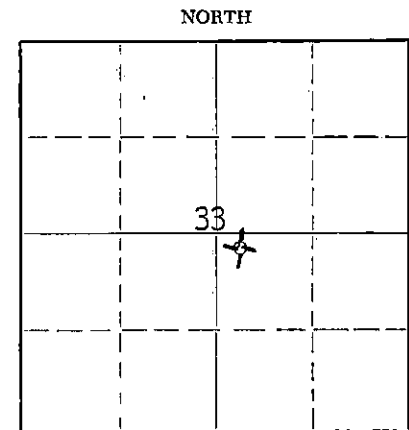

Locate well correctly on above Section Plat

Name of Conservation Agent who supervised plugging of this well Merle Rives

Producing formation Arbuckle Depth to top 3695' Bottom _____ Total Depth of Well _____ Feet

Show depth and thickness of all water, oil and gas formations.

OIL, GAS OR WATER RECORDS

CASING RECORD

FORMATION	CONTENT	FROM	TO	SIZE	PUT IN	PULLED OUT
				5-1/2"		2831'

Describe in detail the manner in which the well was plugged, indicating where the mud fluid was placed and the method or methods used in introducing it into the hole. If cement or other plugs were used, state the character of same and depth placed, from _____ feet to _____ feet for each plug set.

Sanded hole from 3700' to 3690' and ran 5 sacks of cement. Bailed hole to 300', mudded hole to 225', set 10' rock bridge and ran 20 sacks of cement. Mudded hole to 30', set 10' rock bridge and ran 10 sacks of cement. Plugging completed.

RECEIVED
STATE CORPORATION COMMISSION
SEP 10 1952
CONSERVATION DIVISION
Wichita, Kansas
9-10-52

Name of Plugging Contractor West Supply Company
Address Chase, Kansas

STATE OF KANSAS, COUNTY OF RICE, ss.
E. E. O'Brien, of West Supply Company, Chase, Ks (employee of owner) of the above-described well, being first duly sworn on oath, says: That I have knowledge of the facts, statements, and matters herein contained and the log of the above-described well as filed and that the same are true and correct. So help me God.

(Signature) E. E. O'Brien
Chase, Kansas
(Address)

SUBSCRIBED AND SWORN TO before me this 8th day of September, 19 52.

My commission expires 3/1/55 Orlando Miller Notary Public.

PLUGGING
FILE SEC 33 22 R 12 W

KRANKENBERG #1

LOCATION: NW $\frac{1}{4}$ NW $\frac{1}{4}$ SW $\frac{1}{4}$ 33-22S-12W
Stafford County, Kansas

OPERATOR: Birmingham-Bartlett Drilling Co.

CONTRACTOR: Birmingham-Bartlett Drilling Co.

SURFACE CASING: 8-5/8" casing cemented at 209'
with 180 sacks cement and 2 c.c.

OIL STRING: 5 1/2" 14# casing cemented at 3699'
with 150 sacks cement.

SPUDDED: 4-29-52

COMPLETED: 5-12-52

LOG

(Figures indicate bottom of formation)

0 to	160	Sand
	170	Red bed and shale
	209	Shale and shells
	632	Shale and red bed
	655	Anhydrite
	1440	Shale and shells
	1615	Broken lime
	1750	Lime
	2005	Broken lime
	2150	Lime
	2630	Shale and shells
	2950	Shale and lime
	3195	Lime
	3275	Shale
	3297	Brown lime
	3600	Lime
	3650	Conglomerate
	3672	Conglomerate & chert
	3685	Lime
	3698	Conglomerate & chert
	3700	Lime
	3700	Total Depth.

The undersigned Richard Hindery of the Birmingham-Bartlett Drilling Co. hereby certifies that the above is a true and correct log of the formations encountered in drilling the Krankenberg No. 1 well as shown on the daily drilling reports.


BIRMINGHAM-BARTLETT DRILLING CO.

BY Richard Hindery

Subscribed and sworn before me
this 14th day of May, 1952

Vincent L. Genger
Notary Public

My commission expires November 29, 1954.

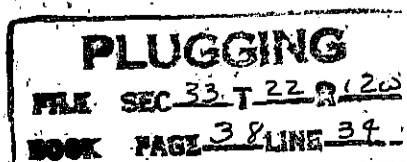

RECEIVED
STATE CORPORATION COMMISSION
SEP 10 1952
CONSERVATION DIVISION
Wichita, Kansas