


STATE OF KANSAS
STATE CORPORATION COMMISSION

WELL PLUGGING RECORD

Give All Information Completely
Make Required Affidavit
Mail or Deliver Report to
Conservation Division
State Corporation Comm.
245 North Water
Wichita, KS 67202

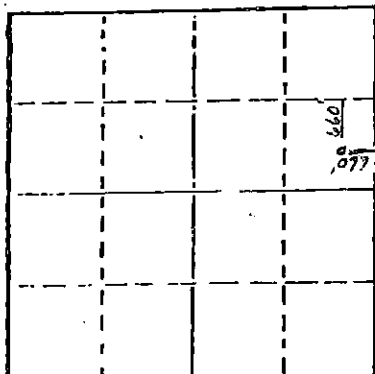

Locate well correctly on above
Section Plot

Reno County. Sec. 6 Twp. 22S Rge. 9W E/W
Location as "NE/CNW1SW1" or footage from lines
SE/4 of NE/4

Lease Owner Equitx Energy Corporation
Lease Name Drake "D" #1 Well No. 1

Office Address P. O. Box 707, Rockwall, Texas 75087
Character of Well (Completed as Oil, Gas or Dry Hole)

Lost circulation

Date Well completed November 30, 1979 19
Application for plugging filed November 30, 1979 19
Application for plugging approved November 30, 1979 19
Plugging commenced 12:30 PM November 30, 1979 19
Plugging completed 1:45 PM November 30, 1979 19
Reason for abandonment of well or producing formation

Lost circulation

If a producing well is abandoned, date of last production 19

Was permission obtained from the Conservation Division or
its agents before plugging was commenced? Yes

Name of Conservation Agent who supervised plugging of this well Gilbert Toman
Producing formation Depth to top Bottom Total Depth of Well 440'
Show depth and thickness of all water, oil and gas formations.

OIL, GAS OR WATER RECORDS

CASING RECORD

FORMATION	CONTENT	FROM	TO	SIZE	PUT IN	PULLED OUT
				7"	195'	None

Describe in detail the manner in which the well was plugged, indicating where the mud fluid was placed and the method or methods used in introducing it into the hold. If cement or other plugs were used, state the character of same and depth placed, from feet to feet for each plug set.

Filled hole with heavy mud.
Plugged with 150 sacks 50/50 Pozmix
with 4% gel; 4 sacks bulls ahead of
plug. Pumped down 7" casing with swage.
No rathole.

12-17-79

RECEIVED
STATE CORPORATION COMMISSION
DEC 17 1979
CONSERVATION DIVISION
Wichita, Kansas

(If additional description is necessary, use BACK of this sheet)

Name of Plugging Contractor Sterling Drilling Company, P. O. Box 129, Sterling, Kansas 67579

STATE OF KANSAS COUNTY OF RICE, ss.
F. A. Wuellner (employee of owner) or (owner or operator)
of the above-described well, being first duly sworn on oath, says: That I have knowledge of the facts, statements, and matters herein contained and the log of the above-described well as filed and that the same are true and correct. So help me God.
STERLING DRILLING COMPANY

(Signature) F. A. Wuellner, Secretary
P. O. Box 129, Sterling, Kansas 67579
(Address)

SUBSCRIBED AND SWORN TO before me this 7th day of December, 19 79



My commission expires

Charles M. Hall, Notary Public.

STERLING DRILLING COMPANY
P. O. Box 129
Sterling, Kansas 67579

WELL LOG - - - - - DRAKE "D" #1
Located: SE/4 of NE/4, Section 6-22S-9W, Reno County, Kansas

OWNER: Equitx Energy Corporation
ROTARY DRILLING CONTRACTOR: Sterling Drilling Company

COMMENCED: November 21, 1979
COMPLETED: November 30, 1979

TOTAL DEPTH: 440'

LOG

0 - 202 Sand and Shale

202 - 440 Shale

CASING RECORD

Ran 5 joints 7", 23# casing. 195.46' set at 195' G.L. Cemented with 200 sacks Class H with 2% gel and 3% cc. Plug down at 5:00 PM, 11-21-79, by Dowell.

Plugged.

RECEIVED
STATE CORPORATION COMMISSION

DEC 17 1979

CONSERVATION DIVISION
Wichita, Kansas