

STATE OF KANSAS
STATE CORPORATION COMMISSION

Form CP-4

WELL PLUGGING RECORD

Give All Information Completely
Make Required Affidavit
Mail or Deliver Report to:
Conservation Division
State Corporation Commission
211 No. Broadway
Wichita, Kansas

Stafford County, Sec. 25 Twp. 22 Rge. 11 ~~W3~~ (W)

Location as "NE/CNW/SW" or footage from lines SW Cor.

Lease Owner Woodman & Iannitti Drilling Co.

Lease Name Salt Marsh Hunting Club Well No. 1

Office Address 706 Union Nat'l. Bldg., Wichita

Character of Well (completed as Oil, Gas or Dry Hole) dry hole

Date well completed 12-22 1963

Application for plugging filed 12-22 1963

Application for plugging approved 12-22 1963


Plugging commenced 12-22 1963

Plugging completed 12-22 1963

Reason for abandonment of well or producing formation dry hole

If a producing well is abandoned, date of last production 19

Was permission obtained from the Conservation Division or its agents before plugging was commenced? yes

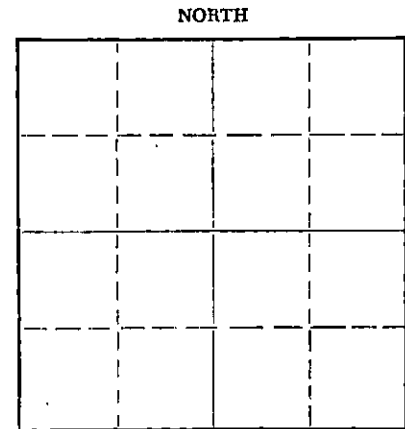

Locate well correctly on above Section Plat

Name of Conservation Agent who supervised plugging of this well Archie V. Elving

Producing formation _____ Depth to top _____ Bottom _____ Total Depth of Well 3715 Feet

Show depth and thickness of all water, oil and gas formations.

OIL, GAS OR WATER RECORDS

CASING RECORD

FORMATION	CONTENT	FROM	TO	SIZE	PUT IN	PULLED OUT
				8 5/8	245	

Describe in detail the manner in which the well was plugged, indicating where the mud fluid was placed and the method or methods used in introducing it into the hole. If cement or other plugs were used, state the character of same and depth placed, from _____ feet to _____ feet for each plug set.

Bottom plug @ 225 w/25 sx. cement
Top plug @ 40 w/10 sx. cement

RECEIVED
STATE CORPORATION COMMISSION

DEC 30 1963

CONSERVATION DIVISION
Wichita, Kansas

12-30-63

(If additional description is necessary, use BACK of this sheet)

Name of Plugging Contractor Woodman & Iannitti Drilling Co.

Address 706 Union Nat'l. Bldg., Wichita

STATE OF Kansas, COUNTY OF Sedgwick, ss.

K. T. Woodman (employee of owner) or (owner or operator) of the above-described well, being first duly sworn on oath, says: That I have knowledge of the facts, statements, and matters herein contained and the log of the above-described well as filed and that the same are true and correct. So help me God.

(Signature)

K. T. Woodman

706 Union Nat'l Bldg
(Address)

SUBSCRIBED AND SWORN TO before me this 24th day of December, 1963

Frances H. Solomon

Notary Public.

My commission expires Oct. 10, 1967

KANSAS GEOLOGICAL SOCIETY
KANSAS WELL LOG BUREAU - KANSAS WELL SAMPLE BUREAU
KANSAS GEOLOGICAL SOCIETY BUILDING
508 EAST MURDOCK - WICHITA, KANSAS

COMPANY Woodman & Iannitti Drilling Co.

SEC. 25 T. 22 R. 11W

FARM Salt Marsh Hunting No. 1
Club

LOC. SW Cor.

TOTAL DEPTH 3715'


COUNTY Stafford

COMM. 12-13-63

COMP. 12-22-63

KANSAS

SHOT OR TREATED

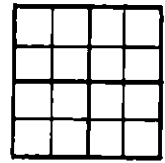

CONTRACTOR Woodman & Iannitti Drilling Co.

ISSUED

CASING

20	10
15	8 5/8 - 245 w/225 sx.
12	6
13	5

ELEVATION 1786 RB

PRODUCTION

FIGURES INDICATE BOTTOM OF FORMATIONS

0 -	150	Sand
	475	Red Bed
	495	Anhydrite
	1590	Shale
	1885	Lime
	2075	Lime & Shale
	2240	Lime
	2460	Lime & Shale
	2790	Shale
	3300	Lime & Shale
	3610	Lime
	3660	Chert, Lime & Shale
	3715	Lime & Chert

I certify the above to be a true and correct copy of the Driller's Log to the best of my knowledge and belief.

WOODMAN & IANNITTI DRILLING CO.

By:

K. T. Woodman

K. T. Woodman

RECEIVED
STATE CORPORATION COMMISSION
DEC 30 1963
CONSERVATION DIVISION
Wichita, Kansas