

STATE OF KANSAS  
STATE CORPORATION COMMISSION

Give All Information Completely  
Make Required Affidavit  
Mail or Deliver Report to:  
Conservation Division  
State Corporation Commission  
211 No. Broadway  
Wichita, Kansas

WELL PLUGGING RECORD

STAFFORD County, Sec. 23 Twp. 22 Rge. 11W (E) (W)

Location as "NE/CNW/SW" or footage from lines SW NE SE

Lease Owner WESTERN PETROLEUM CO., INC.

Lease Name U. S. GOVERNMENT - RICHARDSON Well No. 1

Office Address 925 PATTON ROAD, GREAT BEND, KANSAS

Character of Well (completed as Oil, Gas or Dry Hole) DRY HOLE

Date well completed OCTOBER 28 19 62

Application for plugging filed OCTOBER 28 19 62

Application for plugging approved OCTOBER 28 19 62


Plugging commenced 2:30 PM OCTOBER 28 19 62

Plugging completed 4:30 PM OCTOBER 28 19 62

Reason for abandonment of well or producing formation DRY HOLE

If a producing well is abandoned, date of last production 19

Was permission obtained from the Conservation Division or its agents before plugging was commenced? YES

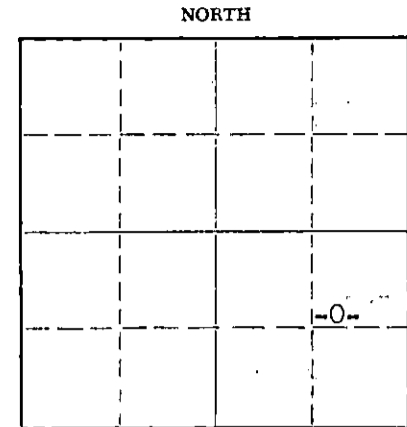

Locate well correctly on above Section Plat

Name of Conservation Agent who supervised plugging of this well W. L. LAC KAMP

Producing formation Depth to top Bottom Total Depth of Well Feet

Show depth and thickness of all water, oil and gas formations.

OIL, GAS OR WATER RECORDS

CASING RECORD

FORMATION	CONTENT	FROM	TO	SIZE	PUT IN	PULLED OUT
		-0-	215	8-5/8	10/19/62	

Describe in detail the manner in which the well was plugged, indicating where the mud fluid was placed and the method or methods used in introducing it into the hole. If cement or other plugs were used, state the character of same and depth placed, from feet to feet for each plug set.

FILLED HOLE WITH ROTARY MUD TO 180' FROM TOP. PUSHED WOODEN PLUG AND HULLS TO FLUID.

CEMENT WITH 20 SXS. CEMENT THROUGH DRILL PIPE. FILLED HOLE TO 35' WITH ROTARY MUD.

PUSHED WOODEN PLUG AND HULLS TO FLUID. CEMENTED WITH 10 SXS. CEMENT. JOB COMPLETED @ 4:30 PM,

10/28/62.

RECEIVED  
STATE CORPORATION COMMISSION

OCT 31 1962

CONSERVATION DIVISION  
Wichita, Kansas

10-31-62

(If additional description is necessary, use BACK of this sheet)

Name of Plugging Contractor

Address

STATE OF KANSAS, COUNTY OF BARTON, ss.

F. I. COPELAND (employee of owner) or (owner or operator) of the above-described well, being first duly sworn on oath, says: That I have knowledge of the facts, statements, and matters herein contained and the log of the above-described well as filed and that the same are true and correct. So help me God.

(Signature) F. I. Copeland

925 PATTON ROAD, GREAT BEND, KANSAS (Address)

SUBSCRIBED AND SWORN TO before me this 29TH day of OCTOBER, 19 62

Ruth M. Kruckenber

RUTH M. KRUCKENBERG Notary Public.

My commission expires JUNE 13, 1966



CASING RECORD: 5 JTS 8-5/8" 20# CASING  
 COMPANY: WESTERN PETROLEUM Co., INC.  
 CONTRACTOR: WESTERN PETROLEUM Co., INC.  
 TOTAL DEPTH: 3609'  
 COMMENCED: OCTOBER 19, 1962  
 COMPLETED: OCTOBER 28, 1962  
 ELEVATION: 1777 DF  
 1779 KB  
 DESCRIPTION: SW NE SE SECTION 23-T22S-R11W STAFFORD COUNTY, KANSAS

FORMATION	FROM	TO	REMARKS
SAND AND CLAY	0	40	RAN 5 JTS. 8-5/8" 20# NEW PIPE (217.23). CEMENTED WITH 220 SXS. SUNSHINE POZMIX. CEMENT AND SET @ 224'. PLUG DOWN @ 5:00 PM, 10/19/62.  DST #1 3534-3553'. OPEN 35 MINUTES. WEAK BLOW FOR 5 MINUTES. RECOVERED 4 FEET ROTARY MUD, NS. IBHP 690#/30", FBHP 540#/30 MIN, IFP-FFP 0#, HH 1945#.  DST #2 3604-3609'. OPEN 1 HR: 15 MIN. STRONG BLOW THROUGHOUT TEST. RECOVERED 1890' FORMATION WATER. IBHP 1170#/30", FBHP 1110#/30", IFP 85#, FFP 805#, HH 1940#.  PLUGGED @ 4:30 PM, 10/28/62.  D & A
SAND AND CLAY	40	110	
RED BED	110	470	
ANHYDRITE	470	475	
SHALE, SHELLS, SALT	475	1310	
SHALE AND SHELLS	1310	1635	
LIME AND SHALE	1635	2250	
SHALE AND LIME	2250	2512	
LIME AND SHALE	2512	2780	
LIME	2780	3078	
LIME AND SHALE	3078	3195	
LIME	3195	3495	
CHERT AND SHALE	3495	3545	
SAND AND SHALE	3545	3553	
SHALE AND SAND	3553	3570	
LIME AND SAND	3570	3595	
SHALE	3595	3609	
RTD	3609		

ELECTRIC LOG TOPS

ANHYDRITE	472	1307
HEEBNER	3019	1240
IATAN	3156	1377
LANSING	3182	1403
B/KC	3462	1647
CONGLOMERATE	3496	1717
VIOLA	3506	1727
SIMPSON	3546	1767
ARBUCKLE	3606	1824
RTD	3609	1830

RECEIVED  
 STATE CORPORATION COMMISSION

OCT 31 1962

CONSERVATION DIVISION  
 Wichita, Kansas

STATE OF KANSAS )  
 COUNTY OF BARTON )

I, THE UNDERSIGNED, BEING DULY SWORN ON OATH, STATE THAT THE ABOVE STATEMENT AND LOG ARE TRUE AND A CORRECT RECORD AND LOG OF THE WELL DRILLED AT THE LOCATION ABOVE DESCRIBED.

WESTERN PETROLEUM CO., INC.

*F. L. Copeland*  
 F. L. COPELAND, DRILLING SUPT.

SUBSCRIBED AND SWORN TO BEFORE ME THIS 29TH DAY OF OCTOBER, 1962.

*Ruth M. Kruckenberg*  
 RUTH M. KRUCKENBERG, NOTARY PUBLIC

MY COMMISSION EXPIRES JUNE 13, 1966