


WELL PLUGGING RECORD

Give All Information Completely
Make Required Affidavit
Mail or Deliver Report to:
Conservation Division
State Corporation Commission
800 Bittling Building
Wichita, Kansas

Stafford County, Sec. 8 Twp. 23 Rge. (E) 11 (W)

Location as "NE/CNW4SW4" or footage from lines NW NW SE
Lease Owner J. F. Darby Oil Company
Lease Name Hornbaker Well No. 1
Office Address 1807 Philtower Bldg., Tulsa, Okla.
Character of Well (completed as Oil, Gas or Dry Hole) Dry Hole
Date well completed 12-14-55 19
Application for plugging filed " 19
Application for plugging approved " 19
Plugging commenced " 19
Plugging completed " 19
Reason for abandonment of well or producing formation Dry Hole

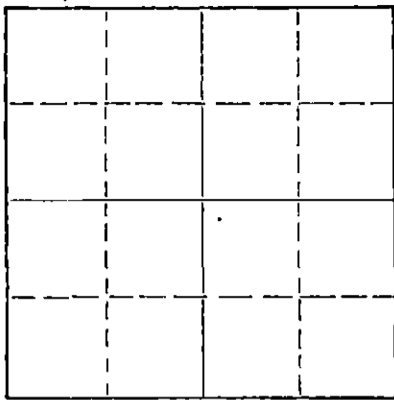

Locate well correctly on above Section Plat

If a producing well is abandoned, date of last production 19
Was permission obtained from the Conservation Division or its agents before plugging was commenced? Yes

Name of Conservation Agent who supervised plugging of this well R. M. Brundage
Producing formation Depth to top Bottom Total Depth of Well 3762 Feet
Show depth and thickness of all water, oil and gas formations.

OIL, GAS OR WATER RECORDS

CASING RECORD

FORMATION	CONTENT	FROM	TO	SIZE	PUT IN	PULLED OUT
Heebner		3178		8-5/8	290	None
Lansing		3300				
Arbuckle		3722				

Describe in detail the manner in which the well was plugged, indicating where the mud fluid was placed and the method or methods used in introducing it into the hole. If cement or other plugs were used, state the character of same and depth placed, from feet to feet for each plug set.

Hole filled with heavy mud to 280'. Plug set with 1/3 sack hulls and 20 sacks cement at 280'. Hole filled with heavy mud to 40' and plug top plug set with 1/3 sack hulls and 10 sacks Cement.

1-6-56

RECEIVED
STATE CORPORATION COMMISSION
JAN 6 1956
CONSERVATION DIVISION
Wichita, Kansas

(If additional description is necessary, use BACK of this sheet)

Name of Plugging Contractor Iron Drilling Company
Address 1206 Philtower Bldg., Tulsa, Okla.

STATE OF Oklahoma, COUNTY OF Tulsa, ss.
J. L. Stackpole (employee of owner) or (owner or operator) of the above-described well, being first duly sworn on oath, says: That I have knowledge of the facts, statements, and matters herein contained and the log of the above-described well as filed and that the same are true and correct. So help me God.

(Signature) J. L. Stackpole

(Address)

SUBSCRIBED AND SWORN TO before me this 21 day of December, 1955

J. Michal Notary Public.

My commission expires Feb. 28, 1956

PLUGGING
FILE SEC 8 T 23 R 11W
BOOK PAGE 24 LINE 16

DRILLING RECORD

15-185-00816-0000

Well No. 1 Hornbaker
 NW NW SE Sec 8-23S-11W
 Stafford County, Kansas

Casing Record

291' of 8-5/8" Surface Pipe cemented
 with 200 sacks cement.

Work Commenced 12/2/55
 Drilling Commenced 12/3/55
 Drilling Completed 12/13/55
 Work Completed 12/14/55

No Oil String - Dry Hole

WELL LOG

Top Soil & Sand	0 to 40
Sand & Gravel	40 to 145
Sand & Clay	145 to 190
Shale & Shells	190 to 557
Anhydrite	557 to 598
Shale & Shells	598 to 1100
Sale	1100 to 1145
Shale & Shells	1145 to 1440
Lime & Shale	1440 to 3378
Lime	3378 to 3383
K.C. Lime	3383 to 3437
Lime & Shale	3437 to 3483
Lime	3483 to 3517
Lime & Shale	3517 to 3602
Lime	3602 to 3615
Lime & Shale	3615 to 3627
Viola Chert	3627 to 3663
Chert & Shale	3663 to 3684
Lime & Shale	3684 to 3722
Arbuckle	3722 to 3762 TD

RECEIVED
 STATE CONSERVATION COMMISSION
 JAN 6 - 1956
 CONSERVATION DIVISION
 Topeka, Kansas

PLUGGING
 FILE SEC 8 T23 R 11W
 BOOK PAGE 24 LINE 16