


WELL PLUGGING RECORD

Give All Information Completely
Make Required Affidavit
Mail or Deliver Report to:
Conservation Division
State Corporation Commission
300 Bitting Building
Wichita, Kansas

NORTH

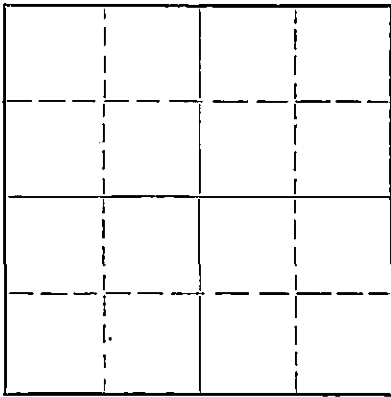

Locate well correctly on above
Section Plat

Stafford County. Sec. 19 Twp. 23 Rge. 11 (H) W (W)
Location as "NE/CNW $\frac{1}{4}$ /SW $\frac{1}{4}$ " or footage from lines W/2 SW NE
Lease Owner The Carl Todd Drilling Company
Lease Name Wendelburg Well No. 2
Office Address 404 KFH Building, Wichita 2, Kansas
Character of Well (completed as Oil, Gas or Dry Hole) Dry Hole
Date well completed 7-29-19 52
Application for plugging filed 7-30-52, 52
Application for plugging approved 7-29-19 52
Plugging commenced 7-29-19 52
Plugging completed 7-29-19 52
Reason for abandonment of well or producing formation Dry Hole

If a producing well is abandoned, date of last production 19...
Was permission obtained from the Conservation Division or its agents before plugging was commenced? Yes

Name of Conservation Agent who supervised plugging of this well C.D. Stough
Producing formation Depth to top Bottom Total Depth of Well 3765 Feet
Show depth and thickness of all water, oil and gas formations.

OIL, GAS OR WATER RECORDS

CASING RECORD

Formation	Content	From	To	Size	Put In	Pulled Out
See attached Drillers Log						

Describe in detail the manner in which the well was plugged, indicating where the mud fluid was placed and the method or methods used in introducing it into the hole. If cement or other plugs were used, state the character of same and depth placed, from... feet to... feet for each plug set.

Filled hole with heavy mud to 250'. Set Plug. Cemented bottom plug with 20 sacks cement. Filled hole with mud to 35'. Set Plug. Cemented plug with 10 sacks cement.

(If additional description is necessary, use BACK of this sheet)

Name of Plugging Contractor The Carl Todd Drilling Company
Address 404 KFH Building, Wichita 2, Kansas

STATE OF Kansas, COUNTY OF Sedgwick, ss.
Carl Todd (employee of owner) or (owner or operator) of the above-described well,

being first duly sworn on oath, says: That I have knowledge of the facts, statements, and matters herein contained and the log of the above-described well as filed and that the same are true and correct. So help me God.

(Signature) Carl Todd
404 KFH Building, Wichita 2, Kansas
(Address)

SUBSCRIBED AND SWORN TO before me this 31st day of July, 19 52.

My commission expires February 8, 1956

PLUGGING 23-8390
FILE SEC-19-T-23R(44)
BOOK PAGE 34 LINE 4

6-51-20M

RECEIVED
STATE CORPORATION COMMISSION
AUG - 1 1952
8-1-52
Notary Public
CONSERVATION DIVISION
Wichita, Kansas

15-185-11978-0000

THE CARL TODD DRILLING COMPANY
404 KFH Building,
Wichita 2, Kansas

The Carl Todd Drilling Company, et al
WENDELBURG No. 2
W/2 SW NE 19-23-11W
Stafford County, Kansas

Date Commenced: July 18, 1952
Date Completed: July 29, 1952

Rotary Tools: 0' to 3765'
Elevation: 1822 R.B.

Casing Record:
8 5/8" casing cemented at 251'
with 170 sacks cement.

Log		Formation Tops	R.B.
0	50	Sand, clay	Heebner. 3111
50	90	Shale	Brown Lime 3288
90	570	Red Bed, shells	Lansing. 3314
570	600	Anhydrite	B/KC. 3579
600	850	Shale, shells	Viola. 3623
850	1340	Shale, shell, sand	Simpson 3659
1340	1455	Shale, shells	Arbuckle 3726
1455	2350	Lime, shale	R.T.D. 3765
2350	2505	Shale, lime	
2505	2685	Lime, shale	
2685	2902	Shale, lime	
2902	2963	Lime	
2963	3075	Lime, shale	
3075	3206	Lime	
3206	3288	Shale, shells	
3288	3632	Lime	
3632	3669	Viola (chirt)	
3669	3692	Simpson	
3692	3730	Lime	
3730	3765	Arbuckle - Total Depth	

Drill Stem Test - 3727' to 3730'
weak blow, open 30 minutes.
Received 35' fluid, 33' watery mud
and 2' slightly oil cut mud in 40
minutes BHP 1050#

I, Carl Todd, do hereby certify that
the above log is correct to the best
of my knowledge and belief.

Carl Todd

PLUGGING
FILE SEC 19 T 23 RLW
PAGE 34 LINE 4

RECEIVED
OIL COMMISSION
AUG - 1 1952
CONSERVATION DIVISION
Wichita, Kansas