

15-185-11977-0500

STATE OF KANSAS
STATE CORPORATION COMMISSION

Give All Information Completely
Make Required Affidavit
Mail or Deliver Report to:
Conservation Division
State Corporation Commission
800 Bittling Building
Wichita, Kansas

WELL PLUGGING RECORD

Stafford County, Sec. 19 Twp. 23 Rge. 11 (E) W (W)

Location as "NE/CNW $\frac{1}{4}$ SW $\frac{1}{4}$ " or footage from lines SE SE NE

Lease Owner Carl Todd Drilling Company

Lease Name Wendelburg Well No. B-1

Office Address 404 KFH Bldg., Wichita, Kansas

Character of Well (completed as Oil, Gas or Dry Hole) Dry

Date well completed 2-29-52 19

Application for plugging filed 3-6-52 19

Application for plugging approved 3-3-52 19


Plugging commenced 2-29-52 19

Plugging completed 2-29-52 19

Reason for abandonment of well or producing formation Dry Hole

If a producing well is abandoned, date of last production - - - - - 19

Was permission obtained from the Conservation Division or its agents before plugging was commenced? Yes

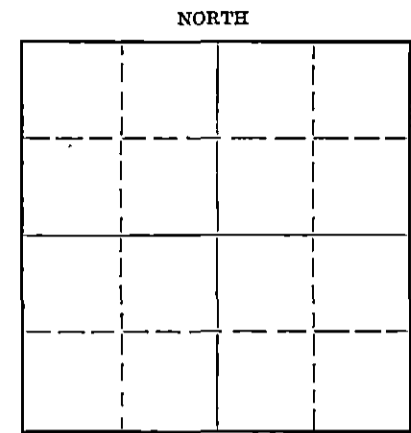

Locate well correctly on above Section Plat

Name of Conservation Agent who supervised plugging of this well C. D. Stough

Producing formation Arbuckle Depth to top 3742 Bottom Total Depth of Well 3785 Feet

Show depth and thickness of all water, oil and gas formations.

OIL, GAS OR WATER RECORDS

CASING RECORD

Formation	Content	From	To	Size	Put In	Pulled Out
See Drillers Log Attached						

Describe in detail the manner in which the well was plugged, indicating where the mud fluid was placed and the method or methods used in introducing it into the hole. If cement or other plugs were used, state the character of same and depth placed, from feet to feet for each plug set.

Filled to 240' with heavy mud. Set plug @ 240' Cemented with 15 sx..
Filled hole with mud to 35' Set plug. Cemented with 10 sx.

(If additional description is necessary, use BACK of this sheet)

Correspondence regarding this well should be addressed to

Address

STATE OF Kansas, COUNTY OF Sedgwick, ss.

(employee of owner) or (owner or operator) of the above-described well, being first duly sworn on oath, says: That I have knowledge of the facts, statements, and matters herein contained and the log of the above-described well as filed and that the same are true and correct. So help me God.

(Signature) Carl Todd

404 KFH Bldg., Wichita, Kansas (Address)

SUBSCRIBED AND SWORN to before me this 6th day of March, 1952.

J. Sealby Notary Public.

My commission expires 2-8-56

23-5091-s 8-50-10M

PLUGGING
FILE SEC 19 T 23 R 11 W
MARCH 7 1952

3-7-52

THE CARL TODD DRILLING COMPANY
 104 KFH Building
 Wichita 2, Kansas

The Carl Todd Drilling Company, et al
 Wendelburg No. B 1
 SE SE NE 19-23S-11W
 Stafford County, Kansas

Date Commenced: February 18, 1952
 Date Completed: February 29, 1952

Rotary Tools: 0' to 3785'
 Elevation: 1832 R.B.

Casing Record:
 8-5/8" casing cemented at 246'
 with 170 sacks cement.
~~casing cemented at 240'~~
~~with~~

LOG		
0	110	Clay, sand, shale
110	575	Red Red, shells
575	600	Anhydrite
600	1100	Shale, shells
1100	1350	Shale, salt
1350	3030	Lime, shale
3030	3115	Lime
3115	3335	Shale, lime
3335	3660	Lime
3660	3700	"Charby" Viola
3700	3742	Simpson
3742	3745	Arbuckle
3745	3785	Arbuckle - Total Depth

FORMATION TOPS	0'	R.B.
Koebner		3152
Toronto		3170
Base Oread		3187
Brown Lime		3296
Lansing		3324
R/K.C.		3592
Viola		3665
Simpson		3684
Arbuckle		3742
R.T.D.		3785

Drill stem test 3743 - 3748, open 45 minutes, shut in 15 minutes, fair to weak blow for 45 minutes, Recovered 130' Sulf. water BHP 1020'.

I, Carl Todd, do hereby certify that the above log is correct to the best of my knowledge and belief.

Carl Todd

PLUGGING
 FILE SEC 19T-23R-11W
 PAGE 148, LINE 4

MAR 7 - 1952
 DIVISION
 Wichita, Kansas