


WELL PLUGGING RECORD

Give All Information Completely
Make Required Affidavit
Mail or Deliver Report to:
Conservation Division
State Corporation Commission
800 Biting Building
Wichita, Kansas

Stafford County. Sec. 30 Twp. 23S Rge. 11 (E) (W)
Location as "NE/CNW/SW" or footage from lines NW/4, NW/4, SW/4
Lease Owner. Rocket Drilling Company, Inc.
Lease Name. Hickman Well No. 1
Office Address. 352 North Broadway, Wichita, Kansas
Character of Well (completed as Oil, Gas or Dry Hole) Dry Hole
Date well completed February 25 19 56
Application for plugging filed " 19 56
Application for plugging approved " 19 56
Plugging commenced February 25 19 56
Plugging completed 9:30 P.M. February 25 19 56
Reason for abandonment of well or producing formation No shows

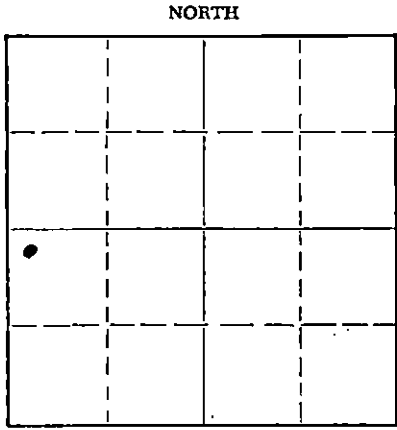

Locate well correctly on above Section Plat

If a producing well is abandoned, date of last production 19
Was permission obtained from the Conservation Division or its agents before plugging was commenced? Yes

Name of Conservation Agent who supervised plugging of this well Mr. Brundege
Producing formation _____ Depth to top _____ Bottom _____ Total Depth of Well 3832 Feet
Show depth and thickness of all water, oil and gas formations.

OIL, GAS OR WATER RECORDS

CASING RECORD

FORMATION	CONTENT	FROM	TO	SIZE	PUT IN	PULLED OUT
				8-5/8"	227	0

Describe in detail the manner in which the well was plugged, indicating where the mud fluid was placed and the method or methods used in introducing it into the hole. If cement or other plugs were used, state the character of same and depth placed, from _____ feet to _____ feet for each plug set.

25 sacks cement @ 240'; 10 sacks cement @ 35'. Filled hole up with mud (per state orders - Mr. Brundege)

(If additional description is necessary, use BACK of this sheet)
Name of Plugging Contractor. Rocket Drilling Company, Inc.
Address. 352 North Broadway, Wichita, Kansas

STATE OF Kansas, COUNTY OF Sedgwick, ss.
L. H. Myrick (employee of owner) or ~~(owner or operator)~~ of the above-described well, being first duly sworn on oath, says: That I have knowledge of the facts, statements, and matters herein contained and the log of the above-described well as filed and that the same are true and correct. So help me God.

(Signature) L. H. Myrick
L. H. Myrick
352 North Broadway, Wichita, Kansas
(Address)


SUBSCRIBED AND SWORN TO before me this 27 day of February, 1956

My commission expires 10/28/1959

Jessie Helmer Jensen
Notary Public.

PLUGGING
FILE SEC 30 T 23 R 11W
BOOK PAGE 41 LINE 40

RECEIVED
FEB 28 1956
CONSERVATION DIVISION
Wichita, Kansas

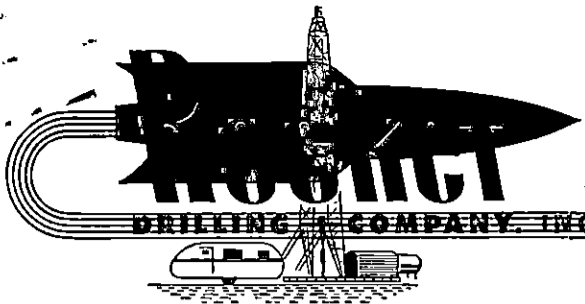

15-185-00922-0000

Rocket Drilling Company, Inc.
 #1 Hickman
 NW/4 NW/4 SW/4 Section 30-23S-11W
 Stafford County, Kansas

Elevation: 1827 D.F.; 1829 R.B.
 Spudded: February 12, 1956
 Rotary Completed: February 25, 1956
 Contractor: Rocket Drilling Company, Inc.

CASING RECORD

227' of 8-5/8" O.D. 24# seamless casing cemented with 150 sacks cement.

DRILLERS LOG

Sand	0 to 90	Lime & Shale	2890
Red Shale	200	Lime	3008
Sand	210	Lime & Shale	3080
Shale	590	Lime	3151
Anhydrite	620	Lime & Shale	3204
Shale & Shells	1670	Shale	3340
Sand	1730	Brown Lime	3375
Lime & Shale	1850	Lime	3700
Sand	1855	Chert	3735
Lime	1890	Lime	3736
Sand	1905	Viola	3772
Lime	2135	Shale	3813
Sand	2150	Lime, Shale &	
Lime	2230	Sand	3832 T.D.

STATE OF KANSAS)
) SS
 COUNTY OF SEDGWICK)

I hereby certify that to the best of my knowledge and belief, the foregoing log is true and correct.

ROCKET DRILLING COMPANY, INC.

By L. H. Myrick
 L. H. Myrick

Subscribed and sworn to before me, a Notary Public, in and for the County and State aforesaid, this 27th day of February, 1956.

Janice Selmer Jones
 Notary Public
 STATE OF KANSAS

My commission expires:
 10/28/1959

PLUGGING
 FILE SEC 30 T 23 R 11W
 BOOK PAGE 41 LINE 40

CONSERVATION
 DIVISION