

STATE OF KANSAS
STATE CORPORATION COMMISSION


WELL PLUGGING RECORD

FORMATION PLUGGING RECORD

All Information Completely
Make Required Affidavit
Mail or Deliver Report to:
Conservation Division
State Corporation Commission
800 Bitting Building
Wichita, Kansas

Strike out upper line
when reporting plugging
off formations.

NORTH

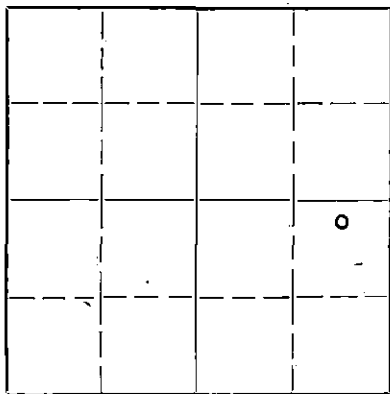

Locate well correctly on above
Section Plat

Stafford

County. Sec. 18 Twp. 22 Rge. 12 (W)

Location as "NE 1/4 NW 1/4 SW 1/4" or footage from lines... C. N/2 NE SE
Lease Owner... C. L. Brosius
Lease Name... M. Teichmann Well No. 1
Office Address... 908 Bitting Bldg., Wichita, Kansas
Character of Well (completed as Oil, Gas or Dry Hole)... DRY
Date well completed... Feb. 15 19 44
Application for plugging filed... Feb. 19 19 44
Application for plugging approved... 19
Plugging commenced... Feb. 16 19 44
Plugging completed... Feb. 16 19 44
Reason for abandonment of well or producing formation... All producing formations dry

If a producing well is abandoned, date of last production... 19
Was permission obtained from the Conservation Division or its agents before plugging was commenced? Yes

Name of Conservation Agent who supervised plugging of this well... C. T. Alexander
Producing formation... Depth to top... Bottom... Total Depth of Well... 3746 Feet

Show depth and thickness of all water, oil and gas formations.

OIL, GAS OR WATER RECORDS

CASING RECORD

Formation	Content	From	To	Size	Pnt In	Pulled Out
				10	240	Cemented with 225 sacks

Describe in detail the manner in which the well was plugged, indicating where the mud fluid was placed and the method or methods used in introducing it into the hole. If cement or other plugs were used, state the character of same and depth placed, from... feet to... feet for each plug set.

Heavy mud circulated from 3746 to 246'. Bridge set at 246' and cemented to 201' through drill pipe. Mud to 26' and bridge set. Cemented from 26' to 6' and soil to 0 10" surface pipe set in hole from 6' to 246'

PLUGGING
FILE SEC 18 TWP 22 RGE 12
BOOK PAGE 129 LINE 25

(If additional description is necessary, use BACK of this sheet)

Correspondence regarding this well should be addressed to C. L. Brosius
Address 908 Bitting Bldg., Wichita, Kansas

STATE OF Kansas, COUNTY OF Sedgwick, ss.
C. L. Brosius (employee of owner) or (owner or operator) of the above-described well,

being first duly sworn on oath, says: That I have knowledge of the facts, statements, and matters herein contained and the log of the above-described well as filed and that the same are true and correct. So help me God.

(Signature) [Handwritten Signature]
908 Bitting Bldg. (Address)

SUBSCRIBED AND SWORN TO before me this 21 day of February 1945

My commission expires January 21, 1945

[Notary Seal] M. L. Owen
Notary Public
FEB 23 1945

C. L. BROSIUS
Teichmann No. 1

SEC. 18 T.22 R.12W
C N/2 NE SE
STAFFORD County

Total Depth 3746'
Comm. 1-31-1944 Comp. 2-15-1944
Contractor H. M. Williams Drilling Co
Abandoned 2-18-1944

PRODUCTION Dry
ELEVATION 1877

CASING

10" 240'
Cemented with 225 sacks cement

Figures Indicate Bottom of Formations

Collar	10	
sand	170	
shale & shells	255	
shale & red bed	405	
shale & lime	880	
shale & shells	1510	
shale & lime	1800	
lime	1995	
lime & shale	2180	
lime & red rock	2285	
lime & shale	2275	
shale & shells	2375	
shale & lime	2540	
shale & lime shells	2645	
shale & shells	2695	
shale & lime	3025	
lime	3070	
lime & shale	3175	
lime	3250	
lime & shale	3350	Top Lansing lime 3340
lime	3575	
lime & shale	3651	Top Viola 3631
chert	3670	
shale	3674	Top Simpson 3675
shale & shells	3720	
shale & lime	3728	Top Arbuckle 3728
Arbuckle lime	3746	
Total Depth	3746	Light show oil 3731-3746

STATE OF KANSAS)
COUNTY OF SEDGWICK) SS

This is to certify that the above is a true and correct copy of the drillers log of the above well.

H. M. Williams

Subscribed and sworn to before me, a notary public, this 21st day of February, 1944.

My Commission expires January 21, 1945

M. S. Owen
Notary Public

PLUGGING
FILE 18-222121
BOOK PAGE 109 LINE 25

FEB 23