

STATE OF KANSAS
STATE CORPORATION COMMISSION

WELL PLUGGING RECORD

OR
FORMATION PLUGGING RECORD

Strike out upper line
when reporting plug-
ging off formations.

Give All Information Completely
Make Required Affidavit
Mail or Deliver Report to:
Conservation Division
State Corporation Commission
800 Bittling Building
Wichita, Kansas

Stafford County. Sec. 32 Twp. 22S Rge. (E) 11 (W)

Location as "NE 1/4 NW 1/4 SW 1/4" or footage from lines NW 1/4 SW 1/4 NW 1/4

Lease Owner The Atlantic Refining Co.

Lease Name Bagley Well No. 1

Office Address Box 17, Great Bend, Kansas

Character of Well (completed as Oil, Gas or Dry Hole) Oil

Date well completed 8-17 19 36

Application for plugging filed 8-24 19 48

Application for plugging approved (by phone) 8-24 19 48

Plugging commenced 8-24 19 48

Plugging completed 8-31 19 48

Reason for abandonment of well or producing formation Depleted formation

If a producing well is abandoned, date of last production 3-24 19 48

Was permission obtained from the Conservation Division or its agents before plugging was commenced? Yes

Name of Conservation Agent who supervised plugging of this well Petty

Producing formation Arbuckle Depth to top 3559 Bottom 3571 Total Depth of Well 3571 Feet

Show depth and thickness of all water, oil and gas formations.

OIL, GAS OR WATER RECORDS

CASING RECORD

Formation	Content	From	To	Size	Put In	Pulled Out
Arbuckle	Oil & water	3559	3571	12 1/2"	203'	None
Simpson	Nothing	3546'	3549'	5 1/2"	3559'	1804'
"	water	3527'	3532'			
Lansing	Nothing	3475'	3480'			
"	Water	3400'	3408'			
"	Some oil & water	3307'	3315'			


Describe in detail the manner in which the well was plugged, indicating where the mud fluid was placed and the method or methods used in introducing it into the hole. If cement or other plugs were used, state the character of same and depth placed, from _____ feet to _____ feet for each plug set.

Previously had Lane-Wells plug at 3464' and plugged back with crushed rock to 3303'.
Ran cement 3303 (5 sacks)
Mud to approximately 200'.
Rock bridge (top at 204')
Cement from 204' up with 20 sacks
Mud to within 25' of surface
Cement from 25' to surface (10 sacks)

9-21-48

(If additional description is necessary, use BACK of this sheet)

Correspondence regarding this well should be addressed to S. K. Myers
Address Box 17, Great Bend, Kansas

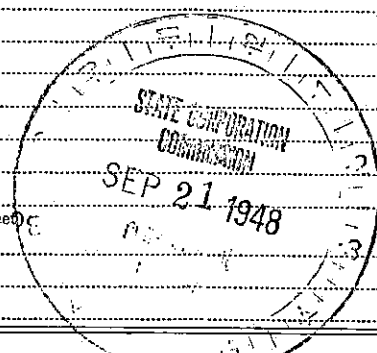

STATE OF Kansas COUNTY OF Barton
O. K. McElheny (employee of owner) or (owner or operator) of the above-described well,
being first duly sworn on oath, says: That I have knowledge of the facts, statements, and matters herein contained and the log of the above-described well as filed and that the same are true and correct. So help me God.

(Signature) O.K. McElheny

P. O. Box 17, Great Bend, Kansas (Address)

SUBSCRIBED AND SWORN to before me this 20th day of September 19 48

My commission expires July 29, 1951 Notary Public.

PLUGGING
FILE SEC 32 T 22 R 116
BOOK PAGE 52 LINE 2

County Stafford
 Farm **AGLEY**
 Owner Atlantic

State Kansas
 Well No. 1

File
 Elevation **1814**

Started 7-14-36 - Completed 8-17-36 NW/Cor S/2 NW/4 32-22S-11W

Formation	TOP	Bottom	Remarks
Sand	0	150	
Red Bed	150	243	
Reamed	243	203	12-1/2" casing at 203 w/ 205 sacks
Red rock	203	330	
Broken sand and red rock	330	410	
Red bed	410	530	
Hydrite	530	560	
Shale	560	580	
Red bed and shale	580	680	
Sandy lime	680	700	
Hydrite	700	720	
Shale	720	740	
Hydrite	740	757	
Shale and broken lime	757	865	
Lime	865	890	
Sandy shale	890	965	
Salt and shale	965	1080	
Shale	1080	1150	
Sandy lime	1150	1180	
Shale	1180	1200	
Broken lime	1200	1257	
Sandy shale	1257	1380	
Hydrite and lime	1380	1433	
Salt	1433	1503	
Hydrite	1503	1520	
Lime	1520	1546	
Shale and lime	1546	1630	
Lime	1630	1645	
Shale	1645	1675	
Lime	1675	1700	
Shale	1700	1715	
Lime	1715	1750	
Shale and lime	1750	1795	
Sand	1795	1825	
Lime	1825	1830	
Broken sand and shale	1830	1895	
Lime	1895	1915	
Shale	1915	1925	
Shale and lime	1925	1966	
Lime and shale	1966	2025	
Shale and lime shells	2025	2100	
Lime	2100	2291	
Lime and shale	2291	2394	
Broken lime	2394	2416	
Shale	2416	2460	
Broken lime	2460	2480	
Lime and shale	2480	2528	
Lime	2528	2551	
Broken lime	2551	2576	
Broken lime and shale	2576	2680	
Shale	2680	2698	
Lime and shale	2698	2730	
Shale	2730	2748	
Shale and sand shells	2748	2780	
Sandy lime	2780	2795	
Lime and shale	2795	2848	
Lime	2848	2868	
Lime with shale breaks	2868	2881	
Lime	2881	2900	
Lime	2900	2972	
Lime and shale	2972	3029	
Lime	3029	3050	
Shale and lime	3050	3068	
Lime	3068	3118	
Shale	3118	3128	3260
Shale and broken lime	3260	3280	
Lime	3280	3300	
Lime and shale	3300	3309	
Reamed	3300	3309	
Broken lime and shale	3309	3347	

TOP BOTTOM

Broken Lime 3347 3380
 Lime, K.C. 3380 3407
 Broken lime and shale 3407 3466
 Lime 3466 3475
 Shale 3475 3485
 Lime 3485 3505
 Shale and broken lime 3505 3535
 Shale 3535 3540
 Reamed core hole 3540 3546
 Shale and lime 3540 3546
 Shale 3546 3551
 Reamed 3540 3551
 Shale 3551 3554
 Lime 3554 3566
 Reamed core hole 3554 3566
 Corrected depth 3571 T.D.

~~5 1/2" casing at~~
 5 1/2" or casing at
 3559 w/ 150 sacks

