


Give All Information Completely
Make Required Affidavit
Mail or Deliver Report to:
Conservation Division
State Corporation Commission
211 No. Broadway
Wichita, Kansas

WELL PLUGGING RECORD

NORTH

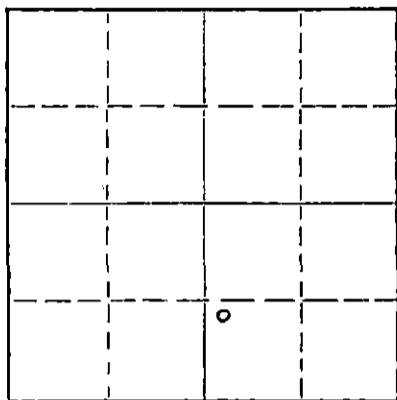

Locate well correctly on above Section Plat

Stafford County, Sec. 28, Twp. 22S, Rge. 11W (E) (W)
Location as "NE/CNW/SW" or footage from lines NW SW SE
Lease Owner Anschutz Drilling Co., Inc.
Lease Name Eigger Well No. 2
Office Address 709 Union Natl. Bank Bldg., Wichita, Kansas
Character of Well (completed as Oil, Gas or Dry Hole) Dry Hole
Date well completed July 27 1956
Application for plugging filed July 27 1956
Application for plugging approved July 27 1956
Plugging commenced July 27 1956
Plugging completed July 27 1956
Reason for abandonment of well or producing formation Dry

If a producing well is abandoned, date of last production 19
Was permission obtained from the Conservation Division or its agents before plugging was commenced? Yes

Name of Conservation Agent who supervised plugging of this well R. M. Brundege
Producing formation _____ Depth to top _____ Bottom _____ Total Depth of Well 3650 Feet
Show depth and thickness of all water, oil and gas formations.

OIL, GAS OR WATER RECORDS

CASING RECORD

FORMATION	CONTENT	FROM	TO	SIZE	PUT IN	PULLED OUT
				8-5/8"	223'	

Describe in detail the manner in which the well was plugged, indicating where the mud fluid was placed and the method or methods used in introducing it into the hole. If cement or other plugs were used, state the character of same and depth placed, from _____ feet to _____ feet for each plug set.

Stirred pits and filled hole with heavy mud with 1/2 sack hulls and wooden plug, pushed to 210' and displaced 20 sacks cement through drill pipe. Filled hole with heavy mud with 1/2 sack hulls and wooden plug, pushed to 35' and displaced 10 sacks cement through drill pipe.

(If additional description is necessary, use BACK of this sheet)

Name of Plugging Contractor Dutch Drilling Co.
Address Great Bend, Kansas

STATE OF Kansas, COUNTY OF Sedgwick, ss.
Shirley Salley (employee of owner) or (owner or operator) of the above-described well, being first duly sworn on oath, says: That I have knowledge of the facts, statements, and matters herein contained and the log of the above-described well as filed and that the same are true and correct. So help me God.

(Signature) Shirley Salley
709 Union Natl. Bank Bldg., Wichita, Kansas
(Address)

SUBSCRIBED AND SWORN TO before me this 30th day of July, 1956

My commission expires April 27, 1959

Kenneth R. Swenson, Notary Public.

PLUGGING
FILE SEC 28 T. 22 R. 11W
BOOK PAGE 85 LINE 6

RECEIVED
CORPORATION COMMISSION
AUG 1 1956
CONSERVATION DIVISION
Wichita, Kansas

DRILLERS' LOG

ANSCHUTZ DRILLING CO., INC.
 #2 FIGGER
 NW SW SE Section 28-22S-11W
 Stafford County, Kansas

<u>FROM</u>	<u>TO</u>	
0	240	Sand and red bed
240	1395	Shale and shells
1395	3055	Shale and lime
3055	3077	Lime
3077	3270	Lime and shale
3270	3330	Kansas City lime
3330	3480	Lime
3480	3515	Cherty lime and shale
3515	3574	Lime, shale and chert
3574	3628	Lime
3628	3645	Lime and shale
3645	3650	Arbuckle lime
	3650	Rotary Total Depth

COMMENCED: 7/18/56

COMPLETED: 7/27/56

CASING RECORD:

Set 223' of 8-5/8" surface casing with 175 sacks cement, 2% gel., 200# calcium chloride.

STATE OF KANSAS)
) SS
 COUNTY OF SEDGWICK)

I hereby affirm that the above and foregoing is a true and correct copy of the formations encountered on the #2 Figger, NW SW SE Section 28-22S-11W, Stafford County, Kansas, as reflected by the daily drilling reports.

ANSCHUTZ DRILLING CO., INC.

By: *Shirley Salley*
 Shirley Salley

Subscribed and sworn to before me this 31st day of July, 1956.

My Commission Expires: April 27, 1959

Benneth R. Swenson
 Benneth R. Swenson, Notary Public

PLUGGING
 FILE SEC 28 T. 22 R. 11W
 BOOK PAGE 75 LINE 6

REGISTERED
 STATE OF KANSAS
 CONSERVATION DIVISION
 WATER CONTROL