


STATE OF KANSAS
STATE CORPORATION COMMISSION

WELL PLUGGING RECORD

Give All Information Completely
Make Required Affidavit
Mail or Deliver Report to:
Conservation Division
State Corporation Commission
800 Biting Building
Wichita, Kansas

Stafford County. Sec. 28 Twp. 22 Rge. 11 ~~xxx~~ (W)
Location as "NE/CNW/SW" or footage from lines NW NW SE
Lease Owner Anschutz Drilling Co., Inc.
Lease Name Figger Well No. One
Office Address 1411 Mile High Center, Denver, Colorado
Character of Well (completed as Oil, Gas or Dry Hole) Dry Hole
Date well completed February 20, 19 56
Application for plugging filed February 20, 19 56
Application for plugging approved February 20, 19 56
Plugging commenced February 20, 19 56
Plugging completed February 20, 19 56
Reason for abandonment of well or producing formation _____

NORTH

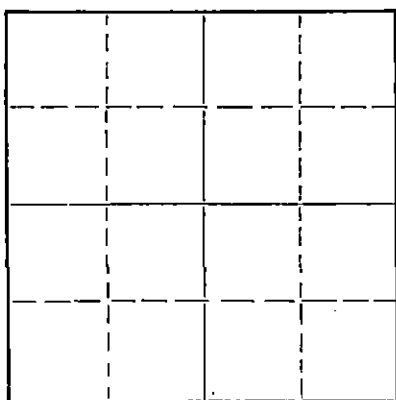

Locate well correctly on above
Section Plat

If a producing well is abandoned, date of last production _____ 19 _____
Was permission obtained from the Conservation Division or its agents before plugging was commenced? yes

Name of Conservation Agent who supervised plugging of this well Mr. R. M. Brundege, Box 283, Hoisington, Kans.
Producing formation _____ Depth to top _____ Bottom _____ Total Depth of Well 3645 Feet
Show depth and thickness of all water, oil and gas formations.

OIL, GAS OR WATER RECORDS

CASING RECORD

FORMATION	CONTENT	FROM	TO	SIZE	PUT IN	PULLED OUT
				8 5/8"	245'	none

Describe in detail the manner in which the well was plugged, indicating where the mud fluid was placed and the method or methods used in introducing it into the hole. If cement or other plugs were used, state the character of same and depth placed, from _____ feet to _____ feet for each plug set.

Bottom plug set at 240' with 20 sacks cement
Top plug set at 40' with 10 sacks cement - cemented to bottom on cellar

2-27-56

RECEIVED
STATE CORPORATION COMMISSION
FEB 27 1956
CONSERVATION DIVISION
Wichita, Kansas

(If additional description is necessary, use BACK of this sheet)
Name of Plugging Contractor Anschutz Drilling Co., Inc.
Address 1411 Mile High Center, Denver, Colorado

STATE OF Colorado, COUNTY OF Denver, ss.
E. G. Koelling (employee of owner) or (owner or operator) of the above-described well, being first duly sworn on oath, says: That I have knowledge of the facts, statements, and matters herein contained and the log of the above-described well as filed and that the same are true and correct. So help me God.

(Signature) E. G. Koelling
1411 Mile High Center, Denver
(Address)

SUBSCRIBED AND SWORN TO before me this 24th day of February, 19 56

My commission expires October 4, 1959
Yvonne M. Robertson Notary Public.

PLUGGING
PAGE SEC 28 T 22 R 11 W
BOOK PAGE 40 LINE 36

DRILLER'S LOG

Anschutz Drilling Co., Inc.
 No. 1 Figger
 NW NW SE Section 28-22-11W
 Stafford County, Kansas

COMMENCED: February 9, 1956
 COMPLETED: February 20, 1956

FROM	TO	
0	20	Surface sand
20	70	Red clay and sand
70	120	Coarse gravel & sand
120	255	Red rock & shale
255	670	Shale
670	1175	Shale & shells
1175	1360	Shale shells & salt
1360	1420	Shale, shells & limestone
1420	1567	Shale & lime streaks
1567	1730	Shale & lime
1730	1740	Sandy lime
1740	1775	Sandy lime
1775	1880	Shale & lime
1880	2140	Lime & shale
2140	2305	Shale & lime
2305	2387	Lime & shale
2387	2585	Shale & shells
2585	2705	Shale
2705	2730	Shale & lime streaks
2730	2825	Lime & shale
2825	2990	Shale & Lime
2990	3105	Lime
3105	3250	Shale
3250	3312	Shale & lime
3312	3362	Lime
3362	3410	Lime with shale streaks
3410	3527	Lime
3527	3570	Lime, shale & cherty conglomerate
3570	3578	Chert
3578	3603	Sandy shale
3603	3645	Sand & shale
3645		ROTARY TOTAL DEPTH

CASING RECORD:
 Set 245' 8 5/8" with 200 sax
 cement 2% calcium chloride.

D & A

RECEIVED
 STATE CORPORATION COMMISSION
 FEB 27 1956
 CONSERVATION DIVISION

STATE OF COLORADO)
 CITY AND COUNTY OF DENVER) SS

I hereby affirm that the above and foregoing is a true and correct copy of the log of the #1 Figger, located in the NW NW SE Section 28-22S-11W, Stafford County, Kansas.

ANSCHUTZ DRILLING CO., INC.

By: *E. G. Koelling*
 E. G. Koelling

Subscribed and sworn to before me this 24th day of February, 1956.

Yvonne M. Robertson
 Yvonne M. Robertson
 Notary Public

My Commission Expires: October 4, 1959.

PLUGGING
 FILE SEC 28-22-11W
 BOOK PAGE 70 LINE 36