

STATE OF KANSAS
STATE CORPORATION COMMISSION

WELL PLUGGING RECORD

Give All Information Completely
Make Required Affidavit
Mail or Deliver Report to:
Conservation Division
State Corporation Commission
300 Bitting Building
Wichita, Kansas


OR

FORMATION PLUGGING RECORD

Strike out upper line
when reporting plug-
ging of formations.

Stafford County. Sec. 28 Twp. 22 Rge. 11 (E) (W)

Location as "NE $\frac{1}{4}$ NW $\frac{1}{4}$ SW $\frac{1}{4}$ " or footage from lines NE NE SE
Lease Owner Alpine Oil & Royalty Co., Inc.
Lease Name Figger Well No. 1
Office Address 300 Bitting Bldg., Wichita, Kansas
Character of Well (completed as Oil, Gas or Dry Hole) Dry hole
Date well completed July 28 19 49
Application for plugging filed July 28 19 49
Application for plugging approved July 28 19 49
Plugging commenced July 28 19 49
Plugging completed July 28 19 49
Reason for abandonment of well or producing formation.....

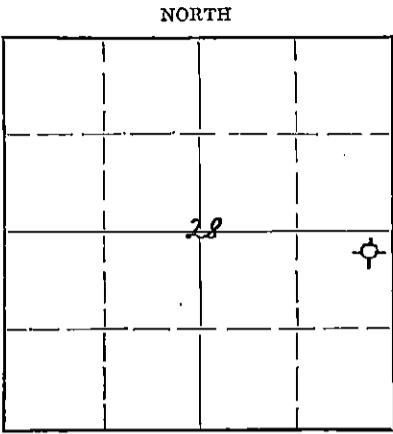

Locate well correctly on above
Section Plat

If a producing well is abandoned, date of last production.....19.....
Was permission obtained from the Conservation Division or its agents before plugging was com-
menced? Yes.

Name of Conservation Agent who supervised plugging of this well C. D. Stough
Producing formation..... Depth to top..... Bottom..... Total Depth of Well 3706 Feet
Show depth and thickness of all water, oil and gas formations.

OIL, GAS OR WATER RECORDS

CASING RECORD

Formation	Content	From	To	Size	Put In	Pulled Out
				8 5/8"	250'	Cemented

Describe in detail the manner in which the well was plugged, indicating where the mud fluid was placed and the method or methods used in introducing it into the hole. If cement or other plugs were used, state the character of same and depth placed, from..... feet to..... feet for each plug set.

Heavy mud from 3706 feet to 250 feet. Solid plug and 15 sacks cement at 250'. Mud to 30' and 10 sacks of cement to surface.

AUG 3 1949
8-3-49
KANSAS

(If additional description is necessary, use BACK of this sheet)

Correspondence regarding this well should be addressed to Alpine Oil & Royalty Co., Inc.
Address 300 Bitting Building, Wichita, Kansas

STATE OF Kansas, COUNTY OF Sedgwick, ss.

DWIGHT J. WILSON (employee of owner) or (owner or operator) of the above-described well, being first duly sworn on oath, says: That I have knowledge of the facts, statements, and matters herein contained and the log of the above-described well as filed and that the same are true and correct. So help me God.

(Signature) Dwight J. Wilson
Secretary
300 Bitting Bldg., Wichita, Kansas

SUBSCRIBED AND SWORN to before me this 2nd day of August, 19 49
Vashti Bell
Notary Public.

My commission expires September 14th, 1949.

PLUGGING
FILE SEC 28 T22 R 114
BOOK PAGE 107 LINE 34

BELL LOG

Alpine Oil & Royalty Co., Inc. et al Elevation: 1812 feet
 Contractor: Quaker Drilling Co., Inc. Commenced: 7-17-49
 Pigger No. 1 Completed: 7-28-49
 NE 1/4 Sec. 23-22-11W Production: D & A
 Stafford County, Kansas

Casing Record:

(3 5/8" 250 cemented with 200 sacks cement.)

<u>FORMATION</u>	<u>DEPTH</u>	<u>FORMATION TOPS</u>	
Surface Clay and Sand	140	Heebnor Shale	3091 -1279
Shale, Lime & Shells	250	Brown Lime	3228 -1416
Shale & Red Bed	520	White Lansing	3253 -1441
Anhydrite Lime S	555	Conglomerate	3545 -1733
Shale & Shells	835	Viola	3569 -1767
Shale, Shells & Salt	1577	Simpson	3595 -1783
Lime & Shale	1615	Arbuckle	3650 -1838
Lime	1905	Total Depth (Rotary)	3706 -1894
Lime & Shale	3010		
Lime	3090		
Lime & Shale	3267		
Lime	3412		
Lime & Shale	3530		
Chert	3595		
Shale & Sand	3650		
Dolomite	3706 TD		

RECEIVED
 Com. Div.
 AUG 3 - 1949
 STATE CORPORATION
 COMMISSION
 KANSAS

I hereby certify that the above is a true and correct copy of the Driller's Log of well drilled in the NE 1/4 of Section 23, Township 22 South, Range 11 West, Stafford County, Kansas

ALPINE OIL & ROYALTY CO., INC.

By

Thomas M. McPaul
 President

Subscribed and sworn to before me this 3rd day of August, 1949.

Wesley Bell
 Notary Public

My Commission expires: September 14, 1949.

PLUGGING
 FILE SEC 28 T 22 R 11W
 BOOK PAGE 107 LINE 34