


WELL PLUGGING RECORD

Give All Information Completely
Make Required Affidavit
Mail or Deliver Report to:
Conservation Division
State Corporation Commission
211 No. Broadway
Wichita, Kansas

NORTH

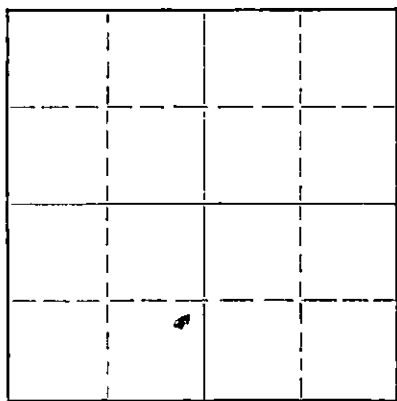

Locate well correctly on above
Section Plat

Stafford County. Sec. 28 Twp. 22S Rge. 11 (~~XXXX~~) (W)
Location as "NE/CNW/SW" or footage from lines NE SE SW
Lease Owner Anschutz Drilling Co., Inc.
Lease Name Lofland Well No. 3
Office Address 1411 Mile High Center, Denver, Colorado
Character of Well (completed as Oil, Gas or Dry Hole) oil
Date well completed July 19 19 56
Application for plugging filed May 28 19 58
Application for plugging approved May 29 19 58
Plugging commenced June 3 19 58
Plugging completed June 5 19 58
Reason for abandonment of well or producing formation lack of production

If a producing well is abandoned, date of last production May 30 19 58
Was permission obtained from the Conservation Division or its agents before plugging was commenced? YES

Name of Conservation Agent who supervised plugging of this well Frank Broadfoot
Producing formation Arbuckle Depth to top 3635 Bottom not drilled thru Total Depth of Well 3639 Feet
Show depth and thickness of all water, oil and gas formations.

OIL, GAS OR WATER RECORDS

CASING RECORD

FORMATION	CONTENT	FROM	TO	SIZE	PUT IN	PULLED OUT
				5 1/2"	3637	3183'

Describe in detail the manner in which the well was plugged, indicating where the mud fluid was placed and the method or methods used in introducing it into the hole. If cement or other plugs were used, state the character of same and depth placed, from _____ feet to _____ feet for each plug set.

Plugged back to 3626 ft. with sand dumped 5 sacks of cement. Mudded hole up to 220 ft. Bailed hole down set 10 ft. rock bridge, dumped 20 sacks of cement, mudded hole up to 40 ft. and set rock bridge dumped 10 sacks of cement.

RECEIVED
STATE CORPORATION COMMISSION

JUN 25 1958

CONSERVATION DIVISION

6-25-58

(If additional description is necessary, use BACK of this sheet)
Name of Plugging Contractor E & L Casing Pulling Co.
Address Great Bend, Kansas

STATE OF Colorado, COUNTY OF Denver, ss.
H. O. Lynch (employee of owner) or ~~(owner or operator)~~ of the above-described well, being first duly sworn to, says: That I have knowledge of the facts, statements, and matters herein contained and the log of the above-described well as filed and that the same are true and correct. So help me God.

(Signature) H. O. Lynch, Production Sup't.

(Address)

SUBSCRIBED AND SWORN TO before me this 23rd day of June, 19 58.

My commission expires 6-18-61

Alice Woodruff
Notary Public.

PLUGGING
FILE SEC 28 T. 22 R. 11W
BOOK PAGE 104 LINE 4

DRILLERS' LOG

FRED B. ANSCHUTZ
#3 LOFLAND
NE SE SW Section 28-22S-11W
Stafford County, Kansas

CONSERVATION DISTRICT
Wichita, Kansas

<u>FROM</u>	<u>TO</u>	
0	235	Sand and red bed
235	375	Red bed and shale
375	1425	Shale and shells
1425	3025	Lime and shale
3025	3078	Lime (Topeka)
3078	3100	Shale and lime (Heebner)
3100	3215	Lime and shale
3215	3495	Lime
3495	3520	Cherty lime
3520	3571	Lime and shale (cherty)
3571	3573	Simpson
3573	3615	Lime and shale
3615	3635	Lime
3635	3638	Arbuckle lime
	3638	Rotary Total Depth

COMMENCED: 7/6/56
COMPLETED: 7/16/56

CASING RECORD:
Set 235' of 8-5/8" surface casing with 175 sacks cement, 2% gel., 200# calcium chloride.
Set 3637 1/2' of 5 1/4" casing with 100 sacks cement.

STATE OF KANSAS)
) SS
COUNTY OF SEDGWICK)

I hereby affirm that the above and foregoing is a true and correct copy of the formations encountered on the #3 Lofland, NE SE SW Section 28-22S-11W, Stafford County, Kansas, as reflected by the daily drilling reports.

ANSCHUTZ DRILLING CO., INC.

By: Shirley Salley
Shirley Salley

PLUGGING
FILE SEC. 28 T. 22 R. 11W
BOOK PAGE 104 LINE 4

Subscribed and sworn to before me this 19th day of July, 1956.

My Commission Expires: April 27, 1959

Kenneth R. Swenson
Kenneth R. Swenson, Notary Public