


WELL PLUGGING RECORD

Give All Information Completely
Make Required Affidavit
Mail or Deliver Report to:
Conservation Division
State Corporation Commission
211 No. Broadway
Wichita, Kansas

Stafford County, Sec. 28 Twp. 22S Rge. 11 (EX)XX (W)
Location as "NE/CNW/SW" or footage from lines SW NE SW
Lease Owner: Anschutz Drilling Co., Inc.
Lease Name: Lofland Well No. 2
Office Address: 1411 Mile High Center, Denver, Colorado
Character of Well (completed as Oil, Gas or Dry Hole) oil
Date well completed June 26 19 56
Application for plugging filed May 28 19 58
Application for plugging approved May 29 19 58
Plugging commenced June 3 19 58
Plugging completed June 5 19 58
Reason for abandonment of well or producing formation lack of production

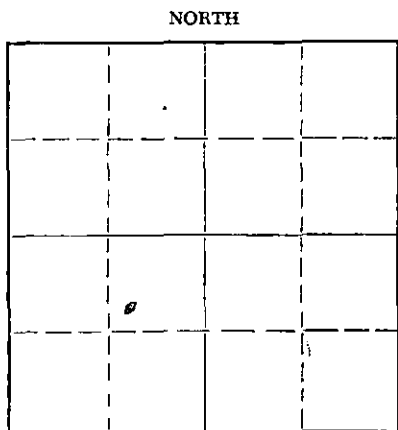

Locate well correctly on above Section Plat

If a producing well is abandoned, date of last production May 28 19 58
Was permission obtained from the Conservation Division or its agents before plugging was commenced? yes

Name of Conservation Agent who supervised plugging of this well Frank Broadfoot
Producing formation Arbuckle Depth to top 3637 Bottom not drilled thru Total Depth of Well 3640 Feet
Show depth and thickness of all water, oil and gas formations.

OIL, GAS OR WATER RECORDS

CASING RECORD

FORMATION	CONTENT	FROM	TO	SIZE	PUT IN	PULLED OUT
				5 1/2"	3638	2999'

Describe in detail the manner in which the well was plugged, indicating where the mud fluid was placed and the method or methods used in introducing it into the hole. If cement or other plugs were used, state the character of same and depth placed, from _____ feet to _____ feet for each plug set.

Plugged back to 3626 ft. with sand dumped 5 sacks of cement.
Mudded hole up to 220 ft. bailed hole down set rock bridge
dumped 20 sacks of cement -mudded hole up to 35 ft. and dumped
10 sacks of cement

6-25-58

(If additional description is necessary, use BACK of this sheet)

Name of Plugging Contractor E & L Casing Pulling Co.
Address Great Bend, Kansas

STATE OF Colorado, COUNTY OF Denver, ss.
H. O. Lynch (employee of owner) or (owner or operator) of the above-described well, being first duly sworn on oath, says: That I have knowledge of the facts, statements, and matters herein contained and the log of the above-described well as filed and that the same are true and correct. So help me God.

(Signature) H. O. Lynch, Production Sup't
(Address)

SUBSCRIBED AND SWORN TO before me this 23rd day of June, 19 58

My commission expires

6-18-61

[Signature]
Notary Public.

PLUGGING
FILE SEC. 28 T. 22 R. 11W
BOOK PAGE 104 LINE 3

WICHITA COLLECTION

MAY 2 1956

Wichita, Kansas

DRILLER'S LOG

Anschutz #2 Lofland
S 2 NE SW Sec. 28-22S-11W
Stafford County, Kansas

FROM	TO	
0	100	Sand
100	255	Red bed
255	700	Shale and Red bed
700	1230	Shale and Salt
1230	1342	Shale and Salt
1342	1513	Fort Riley
1513	3250	Lime and Shale
3250	3473	Lime
3473	3525	Lime and Shale
3525	3640	Lime
	3640	Rotary Total Depth

COMMENCED: 6-8-56

COMPLETED: 6-17-56

CASING RECORD:

Set 252' of 8-5/8" surface casing with 175 sacks cement, 200# calcium chloride, 2% gel.

Set 3638' of 5 1/2" casing with 100 sacks cement.

STATE OF KANSAS)
) SS
COUNTY OF SEDGWICK)

I hereby affirm that the above and foregoing is a true and correct copy of the formations encountered on the #2 Lofland, S 2 NE SW 28-22S-11W, Stafford County, Kansas, as reflected by the daily drilling reports.

ANSCHUTZ DRILLING CO., INC.

By: *Anne Bergen*
Anne Bergen

Subscribed and sworn to before me this 22nd day of June, 1956.

PLUGGING
FILE SEC 28 T 22 R 11W
BOOK PAGE 104 LINE 3

Notary Public