

WELL PLUGGING RECORD

Formerly Anschutz Drilling Co., Inc.

Give All Information Completely
Make Required Affidavit
Mail or Dr. Report to:
Conservation Division
State Corporation Commission
211 No. Broadway
Wichita, Kansas

Stafford County. Sec. 28 Twp. 22 Rge. 11W (E) (W)

Location as "NE/CNW/SE" or footage from lines NE/SW/NE

Lease Owner Paramount Production, Inc.

Lease Name Curtis Well No. #1

Office Address Great Bend, Kansas

Character of Well (completed as Oil, Gas or Dry Hole) Oil

Date well completed 4 - 2 19 56

Application for plugging filed Yes 10 - 10 19 57

Application for plugging approved Yes 10 - 11 19 57


Plugging commenced 10-18 19 57

Plugging completed 10-24 19 57

Reason for abandonment of well or producing formation Production below two bbls oil per day.

If a producing well is abandoned, date of last production 10 - 11 19 57

Was permission obtained from the Conservation Division or its agents before plugging was commenced? Yes

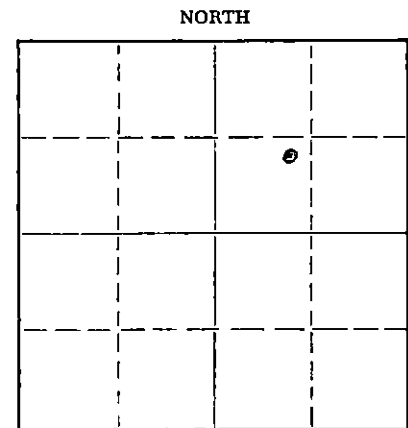

Locate well correctly on above Section Plat

Name of Conservation Agent who supervised plugging of this well Mr. R.M. Brundedge

Producing formation Arbuckle Lime Depth to top 3635 Bottom Total Depth of Well 3638 Feet

Show depth and thickness of all water, oil and gas formations.

OIL, GAS OR WATER RECORDS

CASING RECORD

FORMATION	CONTENT	FROM	TO	SIZE	PUT IN	PULLED OUT
Arbuckle	Oil	3635	3638	5 1/2"	3635 1/2	2,412'

Describe in detail the manner in which the well was plugged, indicating where the mud fluid was placed and the method or methods used in introducing it into the hole. If cement or other plugs were used, state the character of same and depth placed, from feet to feet for each plug set.

Measured into T.D. 3638'.

Plugging started 10-18-57. Finished 10-24-57.

Plugged off bottom with sand to 3625' and dumped 5 sacks cement with bailer. Shot 5 1/2" casing at 2,412'. Pulled pipe out of hole and set plug at 275'. Set permanent rock bridge. Dumped 25 sacks cement. Filled hole with mud to 40' and mixed 10 sacks for cap on well. Well completed.

RECEIVED

11-13-57

NOV 15

CONSERVATION DIVISION
Wichita, Kansas

(If additional description is necessary, use BACK of this sheet)

Name of Plugging Contractor J.O. Forbes d/b/a Forbes Casing Pulling Co.

Address Box 221, Great Bend, Kansas

STATE OF Kansas, COUNTY OF Barton, ss.
J.O. Forbes (employee of owner) or (owner or operator) of the above-described

well, being first duly sworn on oath, says: That I have knowledge of the facts, statements, and matters herein contained and the log of the above-described well as filed and that the same are true and correct. So help me God.

(Signature) J.O. Forbes
Box 221, Great Bend, Kans.
(Address)

SUBSCRIBED AND SWORN TO before me this 31st day of October, 1957.

Betty S. Edman
Notary Public.

My commission expires November 8, 1960.

PLUGGING
FILE SEC. 28 T. 22 R. 11W
BOOK PAGE 52 LINE 32

NOV - 7 1957

ANSCHUTZ DRILLING CO.

DRILLERS' LOG

#1 Curtis
NE SW NE Section 28-225-11W
Stafford County, Kansas

TD 3638

FROM	TO	
0	100	Surface clay and Sand
100	250	Red rock and shells
250	587	Red shale and shells
587	610	Anhydrite and shale
610	730	Shale and shells
730	1220	Shale and shells
1220	1275	Shale, shells and salt
1275	1370	Salt
1370	1435	Shale and Lime shells
1435	1510	Lime and shale
1510	1725	Lime and shale
1725	1765	Sandy Lime
1765	1845	Shale and lime
1845	1905	Lime
1905	1925	Sand
1925	1965	Shale and lime
1965	2235	Lime and shale
2235	2405	Shale and lime shells
2405	2545	Lime and shale
2545	2790	Shale and lime
2790	2895	Lime
2895	3125	Lime and shale
3125	3240	Shale
3240	3248	B. Lime
3248	3295	R.C. Lime
3295	3472	Lime
3472	3520	Lime and shale
3520	3585	Lime shale and chert.
3585	3600	Shale and lime
3600	3630	Slip. sand and shale
3630	3638	Shale and lime
	3698	Rotary Total Depth

COMMENCED: 3-16-56

COMPLETED: 3-28-56

Set 3635¹/₂ of 5-1/2" oil string of casing with 100 sacks cement.

Set 240¹/₂ of 8-5/8" surface casing with 200 sacks cement, 200¹/₂ calcium chloride.

STATE OF KANSAS |
 | 55
COUNTY OF SEDGWICK |

I hereby affirm that the above and foregoing is a true and correct copy of the formations encountered on the No. 1 Curtis, NE SW NE 28-225-11W, Stafford County, Kansas, as reflected by the daily drilling reports.

ANSCHUTZ DRILLING CO., INC.

By: *Lee Mankie*
Lee Mankie

Subscribed and sworn to before me this 10th day of April, 1956.

My Commission Expires May 31, 1956

William H. Johnson
Notary Public

RECORDED
STATE CORPORATION

OCT 13 1957

COMMISSIONER OF REVENUE
STATE OF KANSAS

PLUGGING
FILE SEC. 22 T. 22 R. 11W
BOOK PAGE 52 LINE 32