

STATE OF KANSAS  
STATE CORPORATION COMMISSION

WELL PLUGGING RECORD

Give All Information Completely  
Make Required Affidavit  
Mail or Deliver Report to:  
Conservation Division  
State Corporation Commission  
211 No. Broadway  
Wichita, Kansas

Stafford County, Sec. 28 Twp. 22S Rge. 11 XX (W)

Location as "NE/CNW/SW" or footage from lines NW NW NE

Lease Owner Fred B. Anschutz

Lease Name Curtis Well No. 2

Office Address 709 Union Nat'l Bank Bldg., Wichita, Kansas

Character of Well (completed as Oil, Gas or Dry Hole) Dry Hole

Date well completed May 24, 1956 19 56

Application for plugging filed May 24 19 56

Application for plugging approved May 24 19 56


Plugging commenced May 24 19 56

Plugging completed May 24 19 56

Reason for abandonment of well or producing formation \_\_\_\_\_

If a producing well is abandoned, date of last production \_\_\_\_\_ 19 \_\_\_\_\_

Was permission obtained from the Conservation Division or its agents before plugging was commenced? Yes

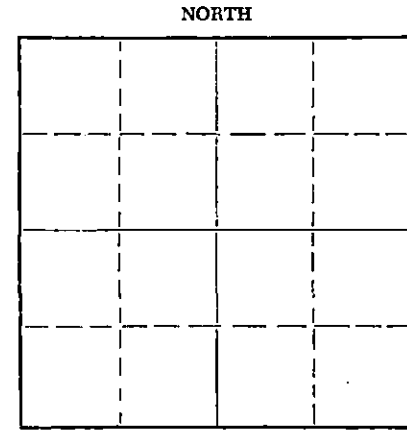

Locate well correctly on above Section Plat

Name of Conservation Agent who supervised plugging of this well R. M. Brundage

Producing formation \_\_\_\_\_ Depth to top \_\_\_\_\_ Bottom \_\_\_\_\_ Total Depth of Well \_\_\_\_\_ Feet

Show depth and thickness of all water, oil and gas formations.

OIL, GAS OR WATER RECORDS

CASING RECORD

FORMATION	CONTENT	FROM	TO	SIZE	PUT IN	PULLED OUT
				8-5/8"	253'	

Describe in detail the manner in which the well was plugged, indicating where the mud fluid was placed and the method or methods used in introducing it into the hole. If cement or other plugs were used, state the character of same and depth placed, from \_\_\_\_\_ feet to \_\_\_\_\_ feet for each plug set.

Filled hole with heavy mud to 240'. Drove Plug to 240'.  
Cemented thru drill pipe with 20 sacks cement. Filled  
hole to 35' and drove plug to 35'. Cemented with 10  
sacks cement.

(If additional description is necessary, use BACK of this sheet)

Name of Plugging Contractor Anschutz Drilling Co., Inc.

Address 709 Union National Bank Bldg., Wichita, Kansas

STATE OF Kansas, COUNTY OF Sedgwick, ss.  
Wilma V. Brokes (employee of owner) or (owner or operator) of the above-described

well, being first duly sworn on oath, says: That I have knowledge of the facts, statements, and matters herein contained and the log of the above-described well as filed and that the same are true and correct. So help me God.

(Signature) Wilma V. Brokes

709 Union National Bank Bldg., Wichita, Ks.  
(Address)

SUBSCRIBED AND SWORN to before me this 29th day of May, 1956

My commission expires Nov. 30, 1959

Lucille L. Arrington Notary Public.

RECEIVED  
STATE CORPORATION COMMISSION

MAY 30 1956  
CONSERVATION DIVISION  
Wichita, Kansas

PLUGGING  
FILE SEC 28 T 22 R 11W  
BOOK PAGE 65 LINE 19

DRILLERS' LOG

Fred B. Anschutz  
 No. 2 Curtis  
 NW NW NE Sec. 28-22S-11W  
 Stafford County, Kansas

FROM	TO	
Surface	70	Sand
70	120	Shale
120	745	Red Bed
745	1160	Shale
1160	1325	Salt
1325	1364	Shale & Lime
1364	1480	Fort Riley
1480	3672	Shale & Lime
3672	3685	Lime
	3685	Total Depth

CASING RECORD:

8-5/8" surface casing  
 set at 253' with 175  
 sacks cement, 400#  
 calcium chloride, and  
 2% gel.

COMMENCED: 5-15-56

COMPLETED: 5-24-56

D & A

STATE OF KANSAS )  
 ) SS  
 COUNTY OF SEDGWICK )

I hereby affirm that the above and foregoing is a true and correct copy of the formations encountered on the No. 2 Curtis, NW NW NE Section 28-22S-11W, Stafford County, Kansas, as reflected by the daily drilling reports.

ANSCHUTZ DRILLING CO., INC.

By: *Wilma V. Brokes*  
 Wilma V. Brokes

Subscribed and sworn to before me this 29th day of May, 1956.

My Commission Expires: Nov. 30, 1959

*Lucille J. Dravington*  
 Notary Public

**PLUGGING**  
 FILE SEC 28 T. 22 R. 11W  
 BOOK PAGE 65 LINE 19