


STATE OF KANSAS
STATE CORPORATION COMMISSION

WELL PLUGGING RECORD

Give All Information Completely
Make Required Affidavit
Mail or Deliver Report to:
Conservation Division
State Corporation Commission
211 No. Broadway
Wichita, Kansas

NORTH

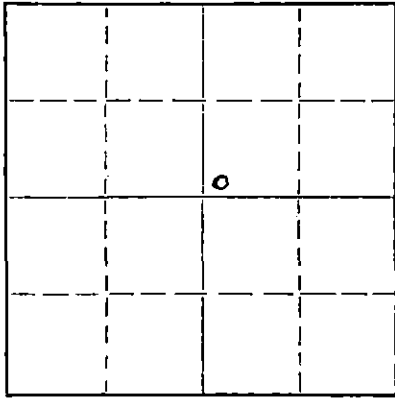

Locate well correctly on above
Section Plat

Stafford County. Sec. 28 Twp. 22S Rge. 11 (E) W (W)
Location as "NE/CNW/SW" or footage from lines SW SW NE
Lease Owner Fred B. Anschutz
Lease Name Curtis Well No. 3
Office Address 709 Union Natl. Bldg., Wichita, Kansas
Character of Well (completed as Oil, Gas or Dry Hole) Dry Hole
Date well completed July 5 19 56
Application for plugging filed July 5 19 56
Application for plugging approved July 5 19 56
Plugging commenced July 5 19 56
Plugging completed July 6 19 56
Reason for abandonment of well or producing formation Dry

If a producing well is abandoned, date of last production _____ 19 ____
Was permission obtained from the Conservation Division or its agents before plugging was commenced? Yes

Name of Conservation Agent who supervised plugging of this well M. A. Rives
Producing formation _____ Depth to top _____ Bottom _____ Total Depth of Well 3641 Feet
Show depth and thickness of all water, oil and gas formations.

OIL, GAS OR WATER RECORDS

CASING RECORD

FORMATION	CONTENT	FROM	TO	SIZE	PUT IN	PULLED OUT
				8-5/8"	248'	

Describe in detail the manner in which the well was plugged, indicating where the mud fluid was placed and the method or methods used in introducing it into the hole. If cement or other plugs were used, state the character of same and depth placed, from _____ feet to _____ feet for each plug set.

Bottom plug set @ 250' with 20 sacks cement.
Top plug set @ 35' with 10 sacks cement.

(If additional description is necessary, use BACK of this sheet)

Name of Plugging Contractor Dutch Drilling Co.
Address Great Bend, Kansas

STATE OF Kansas, COUNTY OF Sedgwick, ss.
Shirley Salley (employee of owner) or (owner or operator) of the above-described well, being first duly sworn on oath, says: That I have knowledge of the facts, statements, and matters herein contained and the log of the above-described well as filed and that the same are true and correct. So help me God.

(Signature) Shirley Salley
709 Union Natl. Bldg., Wichita, Kansas
(Address)

SUBSCRIBED AND SWORN TO before me this 7th day of July 19 56

My commission expires April 27, 1959
 Kenneth A. Stevenson Notary Public.

PLUGGING
FILE SEC 28 T 22 R 11w
BOOK PAGE 78 LINE 11

JUL 10 1956
7-10-56
CONSERVATION DIVISION
Wichita, Kansas

DRILLERS' LOG

FRED B. ANSCHUTZ
 #3 CURTIS
 SW SW NE Section 28-22S-11W
 Stafford County, Kansas

<u>FROM</u>	<u>TO</u>	
0	135	Sand
135	535	Shale and shells
535	565	Anhydrite
565	1340	Shale and shells
1340	1460	Shale and lime
1460	1580	Lime
1580	1870	Lime and shale
1870	1950	Lime
1950	2780	Lime and shale
2780	2890	Lime
2890	3247	Lime and shale
3247	3293	Kansas City lime
3293	3465	Lime
3465	3523	Lime and shale
3523	3532	Lime
3532	3567	Cherty Conglomerate
3567	3612	Lime and shale (cherty)
3612	3641	Lime and shale
	3641	Total Depth

COMMENCED: 6/20/56COMPLETED: 7/6/56CASING RECORD:

Set 248' of 8-5/8" surface casing with 175 sacks cement, 2% gel., 200# calcium chloride.

D & A

STATE OF KANSAS)
) SS
 COUNTY OF SEDGWICK)

I hereby affirm that the above and foregoing is a true and correct copy of the formations encountered on the #3 Curtis, SW SW NE Section 28-22S-11W, Stafford County, Kansas, as reflected by the daily drilling reports.

ANSCHUTZ DRILLING CO., INC.

By: Shirley Salley
 Shirley Salley

Subscribed and sworn to before me this 10th day of July, 1956.

My Commission Expires: April 27, 1959

Kenneth R. Swenson
 Kenneth R. Swenson, Notary Public

PLUGGING			
FILE	SEC. 28	T. 22	R. 11W
BOOK	PAGE 78	LINE	11

JUL 11 1956
 NOTARY PUBLIC