

STATE OF KANSAS
STATE CORPORATION COMMISSION


WELL PLUGGING RECORD

Give All Information Completely
Make Required Affidavit
Mail or Deliver Report to:
Conservation Division
State Corporation Commission
211 No. Broadway
Wichita, Kansas

Stafford County. Sec. 28 Twp. 22 Rge. (E) 11 (W)

Location as "NE/CNWxSWx" or footage from lines SE SE NW 1/4
Lease Owner Petroleum Management, Inc. for Anschutz Drilling Co.
Lease Name Curtis "A" Well No. 1
Office Address 1019 Central Building, Wichita, Kansas
Character of Well (completed as Oil, Gas or Dry Hole) Oil
Date well completed April 14, 1956
Application for plugging filed October 29, 1956
Application for plugging approved October 30, 1956
Plugging commenced November 1, 1956
Plugging completed November 7, 1956
Reason for abandonment of well or producing formation Not Commercial

NORTH

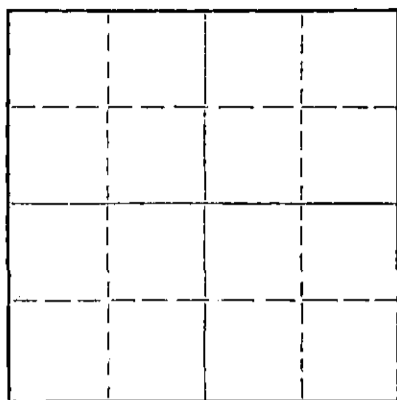

Locate well correctly on above
Section Plat

If a producing well is abandoned, date of last production September 19, 1956
Was permission obtained from the Conservation Division or its agents before plugging was commenced? Yes

Name of Conservation Agent who supervised plugging of this well R. M. Brundege
Producing formation Arbuckle Depth to top 3637 Bottom 3641 Total Depth of Well 3650 Feet
Show depth and thickness of all water, oil and gas formations.

OIL, GAS OR WATER RECORDS

CASING RECORD

FORMATION	CONTENT	FROM	TO	SIZE	PUT IN	PULLED OUT
Arbuckle	Mostly Water	3637	3641	8 5/8"	246	None
	" "	3641	3642	5 1/2	3638	3020
	" "	3642	3643			
	" "	3643	3649			
	Scum of Oil	3649	3650			

Describe in detail the manner in which the well was plugged, indicating where the mud fluid was placed and the method or methods used in introducing it into the hole. If cement or other plugs were used, state the character of same and depth placed, from _____ feet to _____ feet for each plug set.

Plugged back with sand to 3625 ft. Dumped 5 sacks of cement with dump bailer. Mudded hole to 235 ft. Set 10' rock bridge. Dumped 10 sacks of cement to top of surfacepipe.

(If additional description is necessary, use BACK of this sheet)

Name of Plugging Contractor E & L Casing Pulling Co.
Address Great Bend, Kansas

STATE OF Kansas, COUNTY OF Sedgwick, ss. _____ (employee of owner) or (owner or operator) of the above-described well, being first duly sworn on oath, says: That I have knowledge of the facts, statements, and matters herein contained and the log of the above-described well as filed and that the same are true and correct. So help me God.

(Signature) Helen Warrick
1019 Central Building, Wichita, Kansas
(Address)

SUBSCRIBED AND SWORN TO before me this 21st day of November, 1956

My commission expires April 23, 1958

RECEIVED
STATE CORPORATION COMMISSION
Notary Public.

PLUGGING
FILE SEC. 28 T. 22 R. 11W
BOOK PAGE 111 LINE 31

NOV 29 1956
CONSERVATION DIVISION
Wichita, Kansas

D R I L L E R ' S L O G

Fred B. Anschutz
 #1 Curtis "A"
 SE SE NW Sec. 28-22S-11W
 Stafford County, Kansas

Commenced: 4/4/56

Completed: 4/14/56

FROM	TO	
0	90	Surface clay and sand
90	250	Red Rock and Shells
250	555	Red shale and shells
555	580	Anhydrite and shale
580	1100	Shale and shells
1000	1300	Salt
1300	1545	Salt, shale and lime
1545	3118	Shale and lime
3118	3215	Shale
3215	3343	Shale and lime
3343	3539	Lime
3539	3545	Conglomerate
3545	3605	Shale, Chert, and Lime
3605	3637	Lime and shale
3637	3640	Arbuckle
3640		TOTAL DEPTH

Casing Record:

8-5/8" surface csg.
 set at 246' with
 175 sacks cement,
 200# calcium chloride,
 and 100# jel.

5-1/2" oil string of
 casing set at 3637'
 with 100 sacks cement

STATE OF KANSAS)
) SS
 COUNTY OF SEDGWICK)

I hereby affirm that the above and foregoing is a true and correct copy of the formations encountered on the #1 Curtis "A", SE SE NW Section 28-22S-11W, Stafford County, Kansas, as reflected by the daily drilling reports.

ANSCHUTZ DRILLING CO., INC.

By: *Wilma V. Brokes*
 Wilma V. Brokes

Subscribed and sworn to before me this 30th day of April, 1956.

My Commission Expires:
April 27, 1959

Kenneth R. Swenson
 Kenneth R. Swenson, Notary Public

RECEIVED

NOV 21 1956

PETROLEUM MANAGEMENT, INC.

PLUGGING
 FILE SEC. 28 T. 22 R. 11W
 BOOK PAGE 111 LINE 31