


Give All Information Completely
Make Required Affidavit
Mail or Deliver Report to:
Conservation Division
State Corporation Commission
212 North Market, Insurance Bldg.
Wichita, Kansas

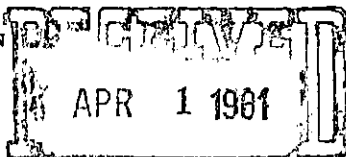

WELL PLUGGING RECORD

ANSCHUTZ DRILLING CO. ^{Stafford} County. Sec. 28 Twp. 22 Rge. 11 (E) W(W)

Location as "NE/CNW/SW" or footage from lines NW/NW/ SE

Lease Owner Anschutz Delg. Co. Inc.

Lease Name Figger Well No. 1

Office Address 1411 Mile High Center Bldg. Denver, Colo.

Character of Well (completed as Oil, Gas or Dry Hole) salt water disposal

Date well completed 12/9 19 56

Application for plugging filed 19

Application for plugging approved 19

Plugging commenced 3/25/61 19


Plugging completed 3/29/61 19

Reason for abandonment of well or producing formation

salt water disposal not needed further

If a producing well is abandoned, date of last production 19

Was permission obtained from the Conservation Division or its agents before plugging was commenced? yes

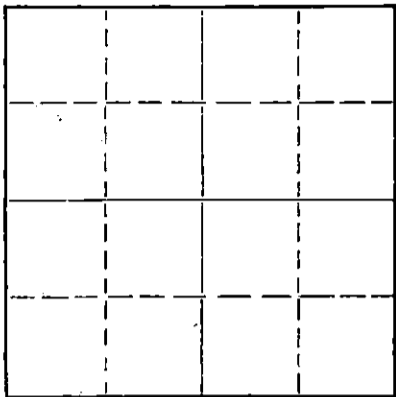

Locate well correctly on above Section Plat

Name of Conservation Agent who supervised plugging of this well Broadfoot

Producing formation _____ Depth to top _____ Bottom _____ Total Depth of Well 3620 Feet

Show depth and thickness of all water, oil and gas formations.

OIL, GAS OR WATER RECORDS

CASING RECORD

FORMATION	CONTENT	FROM	TO	SIZE	PUT IN	PULLED OUT
<u>Arbuckle</u>						<u>3239'</u>

Describe in detail the manner in which the well was plugged, indicating where the mud fluid was placed and the method or methods used in introducing it into the hole. If cement or other plugs were used, state the character of same and depth placed, from _____ feet to _____ feet for each plug set.

Plugged back to 3620 with sand dumped 4 sacks cement.

Set plug at 225 ft. Set 10 foot rock bridge Dumped

20 sacks cement. Mudded hole up to 40 ft. Set rock

bridge dumped 10 sacks cement.

RECEIVED
STATE CORPORATION COMMISSION

APR 5 1961

CONSERVATION DIVISION
WICHITA, KANSAS

4-5-61

Name of Plugging Contractor Central Pipe Pulling Co. (If additional description is necessary, use BACK of this sheet)
Address 1416 Coolidge Great Bend, Kansas

STATE OF Colorado, COUNTY OF Denver, ss.
H. O. Lynch (employee of owner) or (~~owner or operator~~) of the above-described well, being first duly sworn on oath, says: That I have knowledge of the facts, statements, and matters herein contained and the log of the above-described well as filed and that the same are true and correct. So help me God.

(Signature) ANSCHUTZ DRILLING CO., INC.
By: [Signature]
1700 Broadway, Room 1411
Denver, Colorado (address)

SUBSCRIBED AND SWORN TO before me this 3rd day of April, 19 61

My commission expires 8/21/62

Mary Lue Hay
Mary Lue Hay
Notary Public.

DRILLER'S LOG

Anschutz Drilling Co., Inc.
No. 1 Figger
NW NW SE Section 28-22-11N
Stafford County, Kansas

<u>FROM</u>	<u>TO</u>	
0	20	Surface sand
20	70	Red clay and sand
70	120	Coarse gravel & sand
120	255	Red rock & shale
255	670	Shale
670	1175	Shale & shells
1175	1360	Shale shells & salt
1360	1420	Shale, shells & limestone
1420	1567	Shale & lime streaks
1567	1730	Shale & lime
1730	1740	Sandy lime
1740	1775	Sandy lime
1775	1880	Shale & lime
1880	2140	Lime & shale
2140	2305	Shale & lime
2305	2387	Lime & shale
2387	2585	Shale & shells
2585	2705	Shale
2705	2730	Shale & lime streaks
2730	2825	Lime & shale
2825	2990	Shale & lime
2990	3105	Lime
3105	3250	Shale
3250	3312	Shale & lime
3312	3362	Lime
3362	3410	Lime with shale streaks
3410	3527	Lime
3527	3570	Lime, shale & cherty conglomerate
3570	3578	Chert
3578	3603	Sandy shale
3603	3645	Sand & shale
3645		ROTARY TOTAL DEPTH

COMMENCED: February 9, 1956
COMPLETED: February 20, 1956

CASINO RECORD:

Set 245' 3 5/8" with 200 sac
cement 2% calcium chloride.

D & A

RECEIVED
STATE CORPORATION COMMISSION

SEP 7 1962

CONSERVATION DIVISION
Wichita, Kansas

STATE OF COLORADO)
CITY AND COUNTY OF DENVER) SS

I hereby affirm that the above and foregoing is a true and correct copy of the log of the #1 Figger, located in the NW NW SE Section 28-22-11N, Stafford County, Kansas.

ANSCHUTZ DRILLING CO., INC.

By:

E. G. Keeling
E. G. Keeling

Subscribed and sworn to before me this 24th day of February, 1956.

Ivonne M. Robertson
Ivonne M. Robertson
Notary Public

My Commission Expires: October 4, 1959.