


STATE OF KANSAS
STATE CORPORATION COMMISSION

WELL PLUGGING RECORD

Give All Information Completely
Make Required Affidavit
Mail or Deliver Report to:
Conservation Division
State Corporation Commission
211 No. Broadway
Wichita, Kansas

Stafford County, Sec. 19 Twp. 22 Rge. 12 (E) W (W)
Location as "NE/CNW/SW" or footage from lines SE SW SE
Lease Owner Woody's Quality Oil Company
Lease Name Krankenberg Well No. 1
Office Address 1119 Cravens Bldg., Oklahoma City, Oklahoma
Character of Well (completed as Oil, Gas or Dry Hole) Dry Hole
Date well completed 7-14-64 19
Application for plugging filed 7-13-64 19
Application for plugging approved 19
Plugging commenced 7-14-64 19
Plugging completed 7-14-64 19
Reason for abandonment of well or producing formation Dry Hole

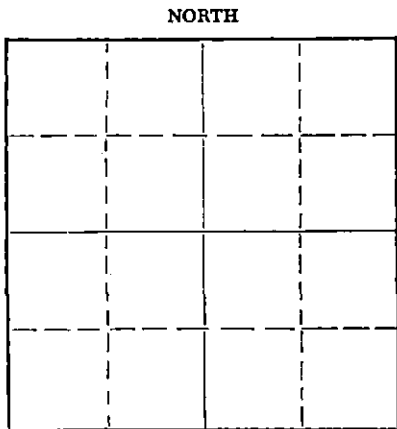

Locate well correctly on above
Section Plat

If a producing well is abandoned, date of last production 19
Was permission obtained from the Conservation Division or its agents before plugging was commenced? Yes

Name of Conservation Agent who supervised plugging of this well Archie Elving
Producing formation Depth to top Bottom Total Depth of Well 3775 Feet
Show depth and thickness of all water, oil and gas formations.

OIL, GAS OR WATER RECORDS

CASING RECORD

FORMATION	CONTENT	FROM	TO	SIZE	PUT IN	PULLED OUT

Describe in detail the manner in which the well was plugged, indicating where the mud fluid was placed and the method or methods used in introducing it into the hole. If cement or other plugs were used, state the character of same and depth placed, from feet to feet for each plug set.

Filled hole with heavy mud--set plug at 250'
1/4 sack hulls and 25 sacks cement
Filled hole with heavy mud to 40' set plug 1/4 sack hulls and 10 sacks cement.
Plugged rat hole 2 sacks cement

RECEIVED
STATE CORPORATION COMMISSION
JUL 16 1964
7-16-64
CONSERVATION DIVISION
Wichita, Kansas

(If additional description is necessary, use BACK of this sheet)

Name of Plugging Contractor
Address

STATE OF Kansas COUNTY OF Barton ss.
L. O. Chubb Contractor (employee of owner) or (owner or operator) of the above-described well, being first duly sworn on oath, says: That I have knowledge of the facts, statements, and matters herein contained and the log of the above-described well as filed and that the same are true and correct. So help me God.

(Signature) [Signature]
Box 823, Great Bend, Kansas
(Address)

SUBSCRIBED AND SWORN TO before me this 15 day of July, 1964

My commission expires 6/24/67
[Signature] Clair E. Stimson Notary Public.



W E L L L O G

Date Commenced: July 6, 1964
 Date Completed: July 14, 1964

WOODY'S QUALITY OIL COMPANY
 KRANKENBERG #1
 SE SW SE Sec. 19-22-12
 Stafford County, Kansas

"ELEVATION"-- 1875 K.B.

0	-	40'	Surface Sand-Clay
40	-	80'	Sand
80	-	180'	Sand-Shale
180	-	681'	Red Bed
681	-	712'	Anhydrite
712	-	1560'	Red Bed Shale
1560	-	2050'	Lime & Shale
2050	-	2785'	Shale-Shells-Lime
2785	-	3193'	Lime
3193	-	3225'	Lime-Shale
3225	-	3323'	Shale
3323	-	3349'	Brown Lime
3349	-	3621'	Lime
3621	-	3639'	Conglomerate
3639	-	3688'	Chert-Shale
3688	-	3750'	sand- Shale
3750	-	3775'	Dolomite

FORMATION DATA


Heebner	3193
Brown Lime	3328
Lansing	3348
Base K.C.	3567
Conglomerate	3621
Viola	3640
Simpson	3681
Arbuckle	3750
RTD	3775

PRODUCTION CASING: Set:
 8 5/8 casing at 263' with
 250 sacks cement

A F F I D A V I T

STATE OF KANSAS
 COUNTY OF BARTON) ss.

L. O. Chubb, of lawful age, does swear that the facts and statements herein contained are true and correct to the best of his knowledge.

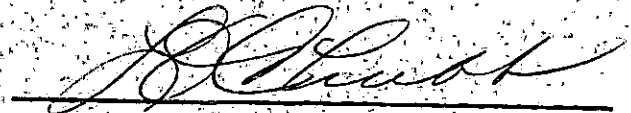

Subscribed and sworn to before me this 15 day of July, 1964.

My Commission Expires:

June 24, 1967


 Clair E. Stumson-Notary Public

RECEIVED
 STATE CORPORATION COMMISSION

JUL 16 1964

CONSERVATION DIVISION
 Wichita, Kansas