

STATE OF KANSAS  
STATE CORPORATION COMMISSION


Form CP-4

WELL PLUGGING RECORD

Give All Information Completely  
Make Required Affidavit  
Mail or Deliver Report to:  
Conservation Division  
State Corporation Commission  
211 No. Broadway  
Wichita, Kansas

Stafford County, Sec. 19 Twp. 22S Rge. (X) 12 (W)  
Location as "NE/CNW/SW" or footage from lines NE SW NW

Lease Owner Lee Phillips Oil Co. & Graves Drilling Co., Inc.  
Lease Name Brensing Well No. 1  
Office Address 1532 Wichita Plaza, Wichita, Kansas  
Character of Well (completed as Oil, Gas or Dry Hole) Dry Hole  
Date well completed November 1, 19 65  
Application for plugging filed November 1, 19 65  
Application for plugging approved November 1, 19 65  
Plugging commenced November 1, 19 65  
Plugging completed November 1, 19 65  
Reason for abandonment of well or producing formation

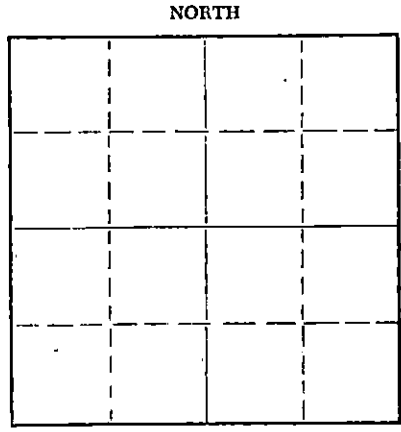

Locate well correctly on above Section Plat

If a producing well is abandoned, date of last production 19  
Was permission obtained from the Conservation Division or its agents before plugging was commenced? Yes

Name of Conservation Agent who supervised plugging of this well Archie V. Elving, Pratt, Kansas  
Producing formation Depth to top Bottom Total Depth of Well 3760 Feet  
Show depth and thickness of all water, oil and gas formations.

OIL, GAS OR WATER RECORDS

CASING RECORD

FORMATION	CONTENT	FROM	TO	SIZE	PUT IN	PULLED OUT

Describe in detail the manner in which the well was plugged, indicating where the mud fluid was placed and the method or methods used in introducing it into the hole. If cement or other plugs were used, state the character of same and depth placed, from feet to feet for each plug set.

Mudded up with heavy mud to 240 feet. Followed by wooden plug and 1/4 sack hulls. Placed 25 sacks cement onto hulls. Mudded up with heavy mud to 40 feet followed by wooden plug, 1/4 sack hulls and 10 sacks cement to base of well cellar. Plugged rat hole with 2 sacks cement.

RECEIVED  
STATE CORPORATION COMMISSION  
NOV 9 1965  
CONSERVATION DIVISION  
Wichita, Kansas

(If additional description is necessary, use BACK of this sheet)  
Name of Plugging Contractor Graves Drilling Co., Inc.  
Address 412 Union Center, Wichita, Kansas

STATE OF KANSAS, COUNTY OF BUTLER, ss.  
John C. Graves (employee of owner) or (owner or operator) of the above-described well, being first duly sworn on oath, says: That I have knowledge of the facts, statements, and matters herein contained and the log of the above-described well as filed and that the same are true and correct. So help me God.

(Signature) John C. Graves  
412 Union Center, Wichita, Kansas 67202  
(Address)

SUBSCRIBED AND SWORN TO before me this 5th day of November, 19 65

My commission expires April 30, 1967  
Betty Brandt Notary Public.

R O T A R Y D R I L L E R S ' L O G

OPERATOR: Lee Phillips Oil Co. and Graves Drilling Co., Inc. DRILLING COMMENCED: October 25, 1965  
412 Union Center  
Wichita, Kansas

CONTRACTOR: Graves Drilling Co., Inc. DRILLING COMPLETED: November 1, 1965  
412 Union Center  
Wichita, Kansas

CASING RECORD: 6 Jts. 264' of 8-5/8" cemented with 300 sacks LOCATION: Breising No. 1  
NE SW NW  
Section 19-22S-12W  
Stafford County, Kansas

-----

0 - 264	Sand, shale & red bed
264 - 990	Shale, shells & red bed
990 - 1498	Shale & shells
1498 - 3190	Lime & shale
3190 - 3203	Lime
3203 - 3368	Lime & shale
3368 - 3576	Lime
3576 - 3610	Lime & shale
3610 - 3617	Lime
3617 - 3634	Lime & shale
3634 - 3692	Chert & lime
3692 - 3707	Sandy, limey shale
3707 - 3754	Shale & sandy shale
3754 - 3760	Lime
3760	Rotary Total Depth

RECEIVED  
STATE CORPORATION COMMISSION  
NOV 9 1965  
CONSERVATION DIVISION  
Wichita, Kansas

I hereby certify the foregoing statements to be true and correct to the best of my knowledge.

GRAVES DRILLING CO., INC.

By Phil Graves  
President

STATE OF KANSAS )  
                          ) SS:  
BUTLER COUNTY )

Subscribed and sworn to before me, a Notary Public, this 5th day of November, 1965.

My commission expires:  
April 30, 1967

Betty Brandt  
Betty Brandt Notary Public