


STATE OF KANSAS  
STATE CORPORATION COMMISSION

Give All Information Completely  
Make Required Affidavit  
Mail of Deliver Report to:  
Conservation Division  
State Corporation Commission  
211 No. Broadway  
Wichita, Kansas

WELL PLUGGING RECORD

Stafford County. Sec. 19 Twp. 22 Rge. (E) 12 (W)  
Location as "NE/CNWxSWx" or footage from lines S/2 SE SW  
Lease Owner Donald T. Ingling et al  
Lease Name Curtis Well No. 1  
Office Address 615 First National Bldg., Wichita, Kansas  
Character of Well (completed as Oil, Gas or Dry Hole) Dry Hole  
Date well completed October 8, 1965  
Application for plugging filed October 8, 1965  
Application for plugging approved October 8, 1965  
Plugging commenced October 8, 1965  
Plugging completed October 8, 1965  
Reason for abandonment of well or producing formation Dry

If a producing well is abandoned, date of last production 19  
Was permission obtained from the Conservation Division or its agents before plugging was commenced? Yes

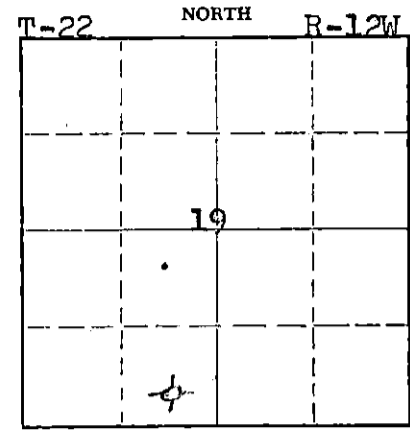

Locate well correctly on above Section Plat

Name of Conservation Agent who supervised plugging of this well A. Elving  
Producing formation \_\_\_\_\_ Depth to top \_\_\_\_\_ Bottom \_\_\_\_\_ Total Depth of Well 3782 Feet  
Show depth and thickness of all water, oil and gas formations.

OIL, GAS OR WATER RECORDS

CASING RECORD

FORMATION	CONTENT	FROM	TO	SIZE	PUT IN	PULLED OUT
				8 5/8"	260'	none

Describe in detail the manner in which the well was plugged, indicating where the mud fluid was placed and the method or methods used in introducing it into the hole. If cement or other plugs were used, state the character of same and depth placed, from \_\_\_\_\_ feet to \_\_\_\_\_ feet for each plug set.

Push plug to 240 feet with sack of hulls on top. Cement with 25 sacks through drill pipe. Mud up to 40 feet and cement base of cellar with 10 sacks - 2 sacks in rat hole

10-14-65

RECEIVED  
STATE CORPORATION COMMISSION

OCT 14 1965

10-14-65  
CONSERVATION DIVISION  
Wichita, Kansas

(If additional description is necessary, use BACK of this sheet)

Name of Plugging Contractor Donald T. Ingling  
Address Wichita, Kansas

STATE OF KANSAS, COUNTY OF SEDGWICK, ss.  
D. T. Ingling (employee of owner) or (owner or operator) of the above-described well, being first duly sworn on oath, says: That I have knowledge of the facts, statements, and matters herein contained and the log of the above-described well as filed and that the same are true and correct. So help me God.

(Signature) [Signature]  
615 First National Bldg., Wichita  
(Address)

SUBSCRIBED AND SWORN TO before me this 12th day of October, 19 65

[Signature]

My commission expires Feb. 27, 1968

Notary Public.

WELL LOG - CURTIS NO. 1

Donald T. Ingling et al, Lease Owner

Section 19-22-12W

Donald T. Ingling, Contractor

Location S/2 SE SW

Commenced: 9-27-65

County: Stafford

Completed: 10-8-65

Production: Dry

Total Depth: 3782'

Elevation: 1879 RB

Casing: 8 5/8" 260' (200 sacks cement)

Figures below indicate bottom formation

40	surface clay	3710	Simpson - top
60	shale	3723	cherty lime and shale
210	sand and shale	3750	shale and conglomerate
260	red bed, shale and shells	3755	shale and sand
722	red rock and shale	3774	Arbuckle - top
715	Anhydrite	3774	shale and sand
745	shale and shells	3782	Arbuckle lime
1050	shale and shells	3782	Total Depth
1490	shale and shells		
1650	lime and shale		
1820	lime and shale		
1992	lime		
2175	lime and shale		
2330	lime and shale		
2455	lime		
2705	shale and lime		
2885	shale and lime		
3010	lime		
3110	lime		
3196	lime		
3210	Hebener - top		
3270	lime		
3345	Brown Lime - top		
3361	KC-Lansing - top		
3370	shale and lime		
3445	lime		
3516	lime		
3570	lime		
3635	lime		
3645	Viola - top		
3691	lime		

RECEIVED  
STATE CORPORATION COMMISSION

OCT 14 1965

CONSERVATION DIVISION  
Wichita, Kansas

I certify this is a true and correct copy of the above mentioned well.

STATE OF KANSAS )  
SEDGWICK COUNTY ) ss.

*D. T. Ingling*

Subscribed and sworn to before me, a Notary Public, in said county and state.

*M. E. Black*

My commission expires: Feb. 27, 1968

Notary Public