

STATE OF KANSAS  
STATE CORPORATION COMMISSION  
200 Colorado Derby Bldg.  
Wichita, Kansas 67202

Form CP-4  
RECEIVED Rev. 12-15-80  
STATE CORPORATION COMMISSION


SEP 25 1981 9-25-81

WELL PLUGGING RECORD

Give All Information Completely  
Make Required Affidavit

CONSERVATION DIVISION  
Wichita, Kansas

COUNTY Stafford SEC. 19 TWP. 22S RGE. 12W E/W  
Location as in quarters or footage from lines:  
SE NW SE

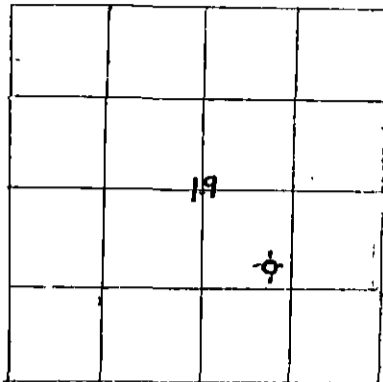

Locate Well  
correctly on above  
Section Platt.

Lease Owner Alpine Drilling Co., Inc.  
Lease Name Krankenbergl Well No. 1  
Office Address 200 E. First, Suite 500, Wichita, KS 67202  
Character of Well (Completed as Oil, Gas or Dry Hole): Dry Hole  
Date Well Completed September 20, 1981  
Application for plugging filed September 20, 1981  
Plugging commenced September 20, 1981  
Plugging completed September 20, 1981  
Reason for abandonment of well or producing formation \_\_\_\_\_

Was permission obtained from the Conservation Division or it's  
Agent's before plugging was commenced? yes

Name of Conservation Agent who supervised plugging of this well Marion Schmidt  
Producing formation \_\_\_\_\_ Depth to top \_\_\_\_\_ bottom \_\_\_\_\_ T.D. 3760'

Show depth and thickness of all water, oil and gas formations.

OIL, GAS OR WATER RECORDS Casing Record

Formation	Content	From	To	Size	Put in	Pulled Out
surface hole	shale	surface	275	8-5/8	271	none
	cemented with 225sx	common,		2% gel, 3% cc,	plug down at noon	
	9-14-81 by Sun.					

Describe in detail the manner in which the well was plugged, indicating where the mud fluid was placed and the method or methods used in introducing it into the hold. If cement or other plugs were used, state the character of same and depth placed, from \_\_\_\_\_ feet to \_\_\_\_\_ feet for each plug set.

Plugged as follows:  
70 sx at 600'; 40 sx @ 240'; 10 sx @ 40', plug and 1/2 sx hulls  
5 sx in rat hole thru drill pipe, 125 sx total 50/50 pos 4% gel, 3% cc,  
plug down at 8:30 p.m. 9-20-81 by Sun.


(If additional description is necessary, use BACK of this sheet)

Name of Plugging Contractor Husky Drilling Co., Inc.

STATE OF KANSAS COUNTY OF SEDGWICK, ss.  
Jon T. Williams, Jr. (employee of owner) or (owner or operator) of the  
above-described well, being first duly sworn on oath, says: That I have knowledge of the  
facts, statements, and matters herein contained and the log of the above-described well as  
filed and that the same are true and correct. So help me God.

(Signature) [Signature]  
200 E. First, Suite 500, Wichita, KS  
(Address)

SUBSCRIBED AND SWORN TO before me this 20th day of September, 19 81

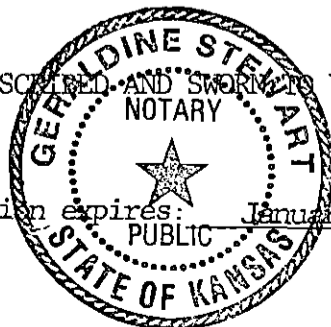

Geraldine Stewart  
Geraldine Stewart Notary Public.

My Commission expires: January 14, 1985



200 East First, Suite 500  
Wichita, Kansas 67202  
Phone 316 - 263-7904  
Mobile Phone 316 - 793-7859 Unit 7070

RECEIVED  
STATE CORPORATION COMMISSION

SEP 25 1981  
September 20, 1981

CONSERVATION DIVISION  
Wichita, Kansas  
No. 1

WELL LOG

Located: SE NW SE of Sec. 19-22S-12W, Stafford County, Kansas

OPERATOR: Alpine Drilling Co., Inc.  
ROTARY CONTRACTOR: Husky Drilling Co., Inc.

COMMENCED: September 14, 1981  
COMPLETED: September 20, 1981

Rotary Total Depth: 3760'

LOG

0 - 170 Sand  
170 - 275 Shale & Red Bed  
275 - 320 Red Bed  
320 - 688 Red Bed & Shale  
688 - 710 Anhydrite  
710 - 1540 Shale & shells  
1540 - 3495 Shale & lime  
3495 - 3588 Lime  
3588 - 3760 Lime & shale

CASING RECORD

Ran 6 jts., used 8-5/8", 28#, tallied 264.59'  
set at 271' KB w/225 sx common, 2% gel,  
3% cc, plug down at noon by Sun; cement  
did circulate.

Plugged & Abandoned 9-20-81.

I certify the above to be a true and correct copy of the drillers log to the best of my knowledge and belief.

HUSKY DRILLING CO., INC.

By   
Jon T. Williams, Jr., President