

STATE OF KANSAS
STATE CORPORATION COMMISSION

Form CP-4


Give All Information Completely
Make Required Affidavit
Mail or Deliver Report to:
Conservation Division
State Corporation Commission
212 No. Market
Wichita, Kansas

WELL PLUGGING RECORD

Stafford County, Sec. 17 Twp. 22S Rge. (E) 12(W)

Location as "NE/CNW&SW" or footage from lines NW NE SE
Lease Owner George A. Reed
Lease Name Stargel (Washdown) Well No. 1
Office Address 1223 Union National Bldg., Wichita, Ks. 67202
Character of Well (completed as Oil, Gas or Dry Hole) Dry Hole
Date well completed Sept. 15 1967
Application for plugging filed 19
Application for plugging approved 19
Plugging commenced September 27, 1967
Plugging completed September 28, 1967
Reason for abandonment of well or producing formation Dry Hole

NORTH

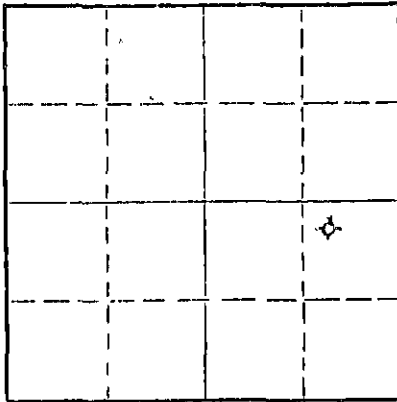

Locate well correctly on above Section Plat

If a producing well is abandoned, date of last production 19
Was permission obtained from the Conservation Division or its agents before plugging was commenced? Yes (Archie Elving - Permit #396)

Name of Conservation Agent who supervised plugging of this well
Producing formation None Depth to top Bottom Total Depth of Well 3727 Feet
Show depth and thickness of all water, oil and gas formations.

OIL, GAS OR WATER RECORDS

CASING RECORD

FORMATION	CONTENT	FROM	TO	SIZE	PUT IN	PULLED OUT
	Surface	0	276'	10 3/4"	12/20/60	-----
	Casing					
	Oil String	0	3726	4 1/2"	8/15/67	262'

Describe in detail the manner in which the well was plugged, indicating where the mud fluid was placed and the method or methods used in introducing it into the hole. If cement or other plugs were used, state the character of same and depth placed, from feet to feet for each plug set.

Heavy Mud from 3250' to 265;
Rock Bridge from 265' to 255';
Run 6 sacks Cement on Bridge;
Bailed Hole & Run 24 Sacks Cement on Bridge;
Mud to 40';
Rock Bridge & 15 Sacks Cement to base of cellar.

11-29-67

RECEIVED
STATE CORPORATION COMMISSION

NOV 29 1967

CONSERVATION DIVISION
Wichita, Kansas

(If additional description is necessary, use BACK of this sheet)
Name of Plugging Contractor Glenn & Smith Pipe Pulling Co.
Address Box 156, Ellinwood, Kansas 67526

STATE OF KANSAS, COUNTY OF SEDGWICK, ss.
George A. Reed (employed by owner) or (owner or operator) of the above-described

well, being first duly sworn on oath, says: That I have knowledge of the facts, statements, and matters herein contained and the log of the above-described well as filed and that the same are true and correct. So help me God.

(Signature) George A. Reed
1223 Union National Bldg., Wichita, Ks.
(Address)

SUBSCRIBED AND SWORN to before me this 2nd day of October, 1967

My commission expires May 3, 1970

Marguerite H. McMahon
Marguerite H. McMahon
Notary Public.

DRILLERS LOGSTARGEL NO. 1 (WASHDOWN)

CASING RECORD:	COMPANY:	Sage Drilling, et al	DESCRIPTION:
8-5/8" @ 276'	CONTRACTOR:	Sage Drilling Co.	NW NE SE Sec. 17-22S-12W Stafford Co., Kansas
TOTAL DEPTH:	COMMENCED:	August 14, 1967	
3727'	COMPLETED:	August 15, 1967	

<u>FROM</u>	<u>TO</u>	<u>REMARKS</u>
0	3697	Washed hole down to old total depth; Ran Drill Stem Test from 3430' to 3446'
3697	3727	Drilled 30 feet of new hole; Set 4½" pipe @ 3726' w/350 sax cement.

I certify that this is a true and correct copy of the operations in the washdown of the above captioned well to the best of my knowledge.

SAGE DRILLING CO., INC.

By Wayne W. Kahmeyer
Wayne W. Kahmeyer

Subscribed and sworn to before me this 17th day of August, 1967.

Louise K. Whitted
Louise K. Whitted - Notary Public

My commission expires:
November 26, 1970.

RECEIVED
STATE CORPORATION COMMISSION

NOV 29 1967

CONSERVATION DIVISION
Wichita, Kansas