

STATE OF KANSAS  
STATE CORPORATION COMMISSION

Give All Information Completely  
Make Required Affidavit  
Mail or Deliver Report to:  
Conservation Division  
State Corporation Commission  
800 Bittling Building  
Wichita, Kansas


WELL PLUGGING RECORD

Stafford

County. Sec. 28 Twp. 22S Rge. 11 (E) W (W)

Location as "NE/CNW/SW" or footage from lines NE/4 NE/4 NW/4  
Lease Owner Charles W. Aikins, Jr., and O. D. Robinson  
Lease Name Tucker Well No. 1  
Office Address 915 Union National Bank Bldg., Wichita 2, Kansas  
Character of Well (completed as Oil, Gas or Dry Hole) Dry Hole  
Date well completed December 16, 19 52  
Application for plugging filed (Verbal Approval Rec'd) 19  
Application for plugging approved (Verbal Approval Rec'd) 19  
Plugging commenced December 16, 19 52  
Plugging completed December 16, 19 52  
Reason for abandonment of well or producing formation Dry Hole

NORTH

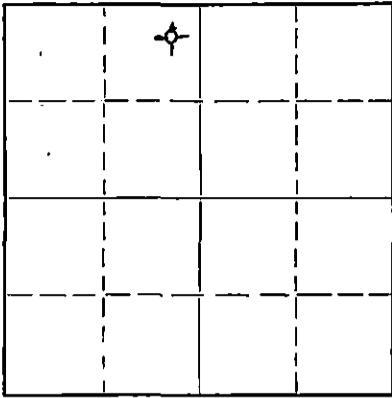

Locate well correctly on above  
Section Plat

If a producing well is abandoned, date of last production \_\_\_\_\_ 19\_\_\_\_  
Was permission obtained from the Conservation Division or its agents before plugging was com-  
menced? Yes

Name of Conservation Agent who supervised plugging of this well M. A. Rives  
Producing formation Arbuckle Dolomite Test Depth to top 396 1/4 Bottom \_\_\_\_\_ Total Depth of Well 397 1/4 Feet  
Show depth and thickness of all water, oil and gas formations.

OIL, GAS OR WATER RECORDS

CASING RECORD

FORMATION	CONTENT	FROM	TO	SIZE	PUT IN	PULLED OUT
		0'	249'	8-5/8"	249'	none

Describe in detail the manner in which the well was plugged, indicating where the mud fluid was placed and the method or methods used in introducing it into the hole. If cement or other plugs were used, state the character of same and depth placed, from \_\_\_\_\_ feet to \_\_\_\_\_ feet for each plug set.

Plugged hole with 1/2 sack hulls and 20 sacks  
cement mixed and poured through drill pipe on  
bottom. Plug set at 240'. 10 sacks cement on  
top. Plug set at 35'.

(If additional description is necessary, use BACK of this sheet)

Name of Plugging Contractor Birmingham-Bartlett Drilling Co.  
Address 300 Kaufman Building, Wichita 2, Kansas

STATE OF KANSAS, COUNTY OF SEDGWICK  
Richard Hindery, partner of Birmingham-Bartlett Drilling Co., drilling contractor  
well, being first duly sworn on oath, says: That I have knowledge of the facts, statements, and matters herein contained and the log of the above-described well as filed and that the same are true and correct. So help me God.

(Signature) Richard Hindery  
(Address) \_\_\_\_\_

SUBSCRIBED AND SWORN TO before me this 23rd day of December, 1952  
Vivian J. Ginger  
Notary Public.

My commission expires December 29, 1954

24-2675-5 2-52-20M

**PLUGGING**  
FILE SEC 21723-R-142  
BOOK FILE 66-LINE-36

DEC 24 1952 12-24-52

CONSERVATION DIVISION  
Wichita, Kansas

TUCKER NO. 1 WELL

LOCATION: NE/4 NE/4 NW/4  
 Section 28-22S-14W  
 Stafford County, Kansas

SPUDDED: 12-4-52  
 COMPLETED: 12-16-52

OPERATOR: Charles W. Aikins, Jr., and O. D. Robinson

CONTRACTOR: Birmingham-Bartlett Drilling Co.

SURFACE CASING: 8 5/8" casing cemented at 249' with  
 225 sacks cement and 2 cc.

OIL STRING: None set. D&A.

LOG

(Figures indicate bottom of formation.)

0 -	120	Sand and shale
	249	Shale and shells
	300	Clay shale and shells
	390	Sand
	830	Red rock and shale
	890	Anhydrite
	1650	Shale and shells
	1775	Broken lime
	1915	Broken lime and shale
	2150	Broken lime
	2280	Broken lime and shale
	2400	Shale and lime
	2645	Shale and shells
	2655	Lime and shale
	3085	Shale and shells
	3275	Shale and lime
	3395	Lime
	3505	Lime and shale
	3507	Shale
	3517	Brown lime
	3745	Lime
	3800	Lime and shale
	3870	Lime
	3893	Viola
	3910	Shale
	3950	Shale, lime and sand
	3960	Lime and shale
	3974	Lime
	3974	RTD

RECORDED  
 STATE OF KANSAS  
 DECEMBER 22 1952  
 CONSERVATION DIVISION  
 Wichita, Kansas

The undersigned, Richard Hindery, one of the partners of Birmingham-Bartlett Drilling Co., hereby certifies that the above is a true and correct log of the formations encountered in drilling the Tucker No. 1 Well as shown in the daily drilling reports.

BIRMINGHAM-BARTLETT DRILLING CO.

By Richard Hindery

Subscribed and sworn to before me  
 this 19th day of December, 1952.

Werner F. Ingber  
 Notary Public

My commission expires December 29, 1954

**PLUGGING**  
 FILE SEC 28 T 22 S 14 W  
 BOOK PAGE 66 LINE 36