

STATE OF KANSAS
STATE CORPORATION COMMISSION

Form CP-4

Give All Information Completely
Make Required Affidavit
Mail or Deliver Report to:
Conservation Division
State Corporation Commission
212 No. Market
Wichita, Kansas 67202

WELL PLUGGING RECORD

Stafford County, Sec. 28 Twp. 22S Rge. 14 (E) X (W)

Location as "NE/CNW&SW" or footage from lines SW SE NE

Lease Owner L. V. Stan Bell

Lease Name No. 1 Tucker Well No. _____

Office Address 562 Westmore Court, Wichita, Kansas

Character of Well (completed as Oil, Gas or Dry Hole) D&A

Date well completed 11/2/70 19__

Application for plugging filed 11/2/70 19__

Application for plugging approved 11/2/70 19__


Plugging commenced 11/2/70 19__

Plugging completed 11/2/70 19__

Reason for abandonment of well or producing formation D&A

If a producing well is abandoned, date of last production _____ 19__

Was permission obtained from the Conservation Division or its agents before plugging was commenced? yes

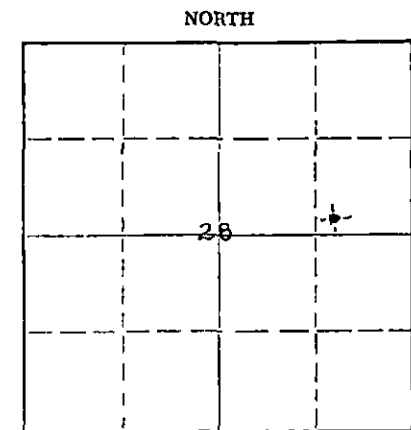

Locate well correctly on above Section Flat

Name of Conservation Agent who supervised plugging of this well Archie V. Elving

Producing formation _____ Depth to top _____ Bottom _____ Total Depth of Well 3687' Feet

Show depth and thickness of all water, oil and gas formations.

OIL, GAS OR WATER RECORDS

CASING RECORD

FORMATION	CONTENT	FROM	TO	SIZE	PUT IN	PULLED OUT
				8 5/8"	243'	-0-

Describe in detail the manner in which the well was plugged, indicating where the mud fluid was placed and the method or methods used in introducing it into the hole. If cement or other plugs were used, state the character of same and depth placed, from _____ feet to _____ feet for each plug set.

Plugged hole with 120 sx 50-50 posmix 6 % total gel., squeezed into formation.

RECEIVED
STATE CORPORATION COMMISSION
DEC 3 - 1970
CONSERVATION DIVISION
Wichita, Kansas
12-3-70

(If additional description is necessary, use BACK of this sheet)

Name of Plugging Contractor Red Tiger Drilling Co.

Address 1720 Wichita Plaza, Wichita, Kansas

STATE OF Kansas, COUNTY OF Sedgwick, ss.

Jim Farrice (employee of owner) or (owner or operator) of the above-described well, being first duly sworn on oath, says: That I have knowledge of the facts, statements, and matters herein contained and the log of the above-described well as filed and that the same are true and correct. So help me God.

(Signature) Jim Farrice

1720 Wichita Plaza, Wichita, Kansas

(Address)


4th day of November, 19__ 70

Gloria Fawcett

Notary Public.

SUBSCRIBED AND SWORN to before me this _____ day of _____, 19__

October 25, 1972

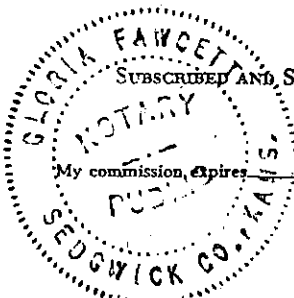

RECEIVED
STATE CORPORATION COMMISSION
DEC 3 - 1970
CONSERVATION DIVISION
Wichita, Kansas

DRILLERS LOG

No. 1 Tucker

CASING RECORD:	COMPANY:	L. V. Stan Bell	DESCRIPTION:
8 5/8" @ 243' w/250 sx cement	CONTRACTOR:	Red Tiger Drilling Co.	SW SE NE 28-22S-14W Stafford County, Kansas
	COMMENCED:	October 27, 1970	
	COMPLETED:	November 2, 1970	
TOTAL DEPTH: 3687'			ELEVATION:


<u>FORMATION</u>	<u>FROM</u>	<u>TO</u>	<u>REMARKS</u>
Sand	0	80	
Shale	80	255	
Shale & Sand	255	880	
Shale	880	1650	
Shale, lime	1650	3527	
Lime	3527	3687	

I certify that this is a true and correct copy of the above log to the best of my knowledge.

RED TIGER DRILLING COMPANY

Jim Farrice
Jim Farrice

Subscribed and sworn to before me this 4th day of November, 1970

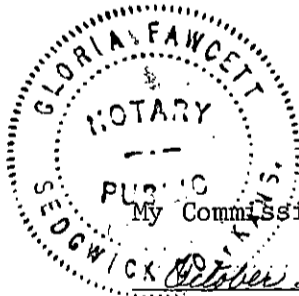

Gloria Fawcett
Notary Public

My Commission Expires:

October 25, 1972