


STATE OF KANSAS  
STATE CORPORATION COMMISSION

Form CP-4

WELL PLUGGING RECORD

Give All Information Completely  
Make Required Affidavit  
Mail or Deliver Report to:  
Conservation Division  
State Corporation Commission  
212 No. Market  
Wichita, Kansas

NORTH

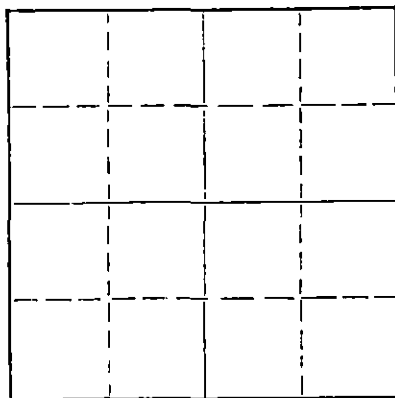

Locate well correctly on above  
Section Plat

Stafford County, Sec. 25 Twp. 22S Rge. (W) 14(W)  
Location as "NE/CNW/SW" or footage from lines SW SW SE  
Lease Owner John C. Graves, et al  
Lease Name Curtis Well No. 1  
Office Address 412 Union Center, Wichita, Kansas  
Character of Well (completed as Oil, Gas or Dry Hole) Dry Hole  
Date well completed June 16, 1966  
Application for plugging filed June 16, 1966  
Application for plugging approved June 16, 1966  
Plugging commenced June 16, 1966  
Plugging completed June 16, 1966  
Reason for abandonment of well or producing formation

If a producing well is abandoned, date of last production 19  
Was permission obtained from the Conservation Division or its agents before plugging was commenced? Yes

Name of Conservation Agent who supervised plugging of this well Archie Elving, Pratt, Kansas  
Producing formation Depth to top Bottom Total Depth of Well 3870 Feet  
Show depth and thickness of all water, oil and gas formations.

OIL, GAS OR WATER RECORDS

CASING RECORD

FORMATION	CONTENT	FROM	TO	SIZE	PUT IN	PULLED OUT
				8-5/8"	365'	None

Describe in detail the manner in which the well was plugged, indicating where the mud fluid was placed and the method or methods used in introducing it into the hole. If cement or other plugs were used, state the character of same and depth placed, from feet to feet for each plug set.

Mudded up with heavy mud to 300 feet. Followed by wooden plug and 1/2 sack hulls. Placed 25 sacks cement onto hulls. Mudded up with heavy mud to 40 feet followed by wooden plug, 1/2 sack hulls and 10 sacks cement to base of well cellar. Plugged rat hole with 2 sacks cement.

RECEIVED  
STATE CORPORATION COMMISSION

JUN 24 1966

Conservation Division  
Wichita, Kansas

6-24-66

(If additional description is necessary, use BACK of this sheet)  
Name of Plugging Contractor Graves Drilling Co., Inc.  
Address 412 Union Center, Wichita, Kansas

STATE OF KANSAS, COUNTY OF BUTLER, ss.  
John C. Graves (employee of owner) or (owner or operator) of the above-described well, being first duly sworn on oath, says: That I have knowledge of the facts, statements, and matters herein contained and the log of the above-described well as filed and that the same are true and correct. So help me God.

(Signature) John C. Graves  
412 Union Center, Wichita, Kansas 67202  
(Address)

SUBSCRIBED AND SWORN TO before me this 22nd day of June, 1966

My commission expires April 30, 1967  
Betty Brandt Notary Public

ROTARY DRILLERS' LOG

OPERATOR: John C. Graves, et al DRILLING COMMENCED: June 10, 1966  
 412 Union Center  
 Wichita, Kansas

CONTRACTOR: Graves Drilling Co., Inc. DRILLING COMPLETED: June 16, 1966  
 412 Union Center  
 Wichita, Kansas

CASING RECORD: 12 Jts. 365' 8-5/8" LOCATION: Curtis No. 1  
 cemented with 375 sacks SW SW SE  
 Section 25-22S-14W  
 Stafford County, Kansas

-----

0 - 250 Sand & shale  
 250 - 295 Red bed  
 295 - 340 Sand  
 340 - 365 Shale  
 365 - 850 Red bed  
 850 - 1488 Red bed, shale & shells  
 1488 - 1700 Shale & lime  
 1700 - 2020 Lime & shale  
 2020 - 2324 Shale & lime  
 2324 - 2510 Lime & shale  
 2510 - 2800 Shale & lime  
 2800 - 3261 Lime & shale  
 3261 - 3326 Lime  
 3326 - 3347 Lime & shale  
 3347 - 3725 Lime  
 3725 - 3755 Lime & shale  
 3755 - 3789 Lime  
 3789 - 3817 Sandy shale & sand  
 3817 - 3870 Lime  
 3870 Rotary Total Depth

RECEIVED  
 STATE CORPORATION COMMISSION

JUN 24 1966

CONSERVATION DIVISION  
 Wichita, Kansas

I hereby certify the foregoing statements to be true and correct to the best of my knowledge.

GRAVES DRILLING CO., INC.

By John C. Graves  
 President

STATE OF KANSAS )  
 ) SS:  
 BUTLER COUNTY )

Subscribed and sworn to before me, a Notary Public, this 22nd of June, 1966.

My commission expires:  
 April 30, 1967

Betty Brandt  
 Betty Brandt Notary Public