


Give All Information Completely  
Make Required Affidavit  
Mail or Deliver Report to:  
Conservation Division  
State Corporation Commission  
800 Bittig Building  
Wichita, Kansas

WELL PLUGGING RECORD

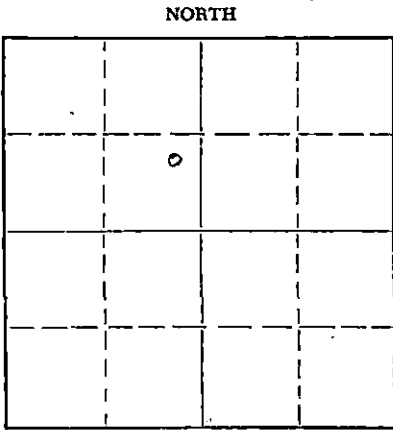

Locate well correctly on above  
Section Plat

Stafford County. Sec. 21 Twp. 22 Rge. 14 (E) W (W)  
Location as "NE/CNW/SW" or footage from lines NE SE NW  
Lease Owner Harms-Burt Drilling Company  
Lease Name Neeland Well No. 1  
Office Address Box 184, Great Bend, Kansas  
Character of Well (completed as Oil, Gas or Dry Hole) Dry Hole  
Date well completed September 30 1955  
Application for plugging filed " " 1955  
Application for plugging approved " " (orally) 1955  
Plugging commenced " " 1955  
Plugging completed " " 1955  
Reason for abandonment of well or producing formation Dry Hole

If a producing well is abandoned, date of last production \_\_\_\_\_ 19\_\_\_\_  
Was permission obtained from the Conservation Division or its agents before plugging was commenced? Yes

Name of Conservation Agent who supervised plugging of this well M. A. Rives, Pratt, Kansas  
Producing formation \_\_\_\_\_ Depth to top \_\_\_\_\_ Bottom \_\_\_\_\_ Total Depth of Well 3745 Feet  
Show depth and thickness of all water, oil and gas formations.

OIL, GAS OR WATER RECORDS

CASING RECORD

FORMATION	CONTENT	FROM	TO	SIZE	PUT IN	PULLED OUT
Surface		0	205	8 5/8"	205	None

Describe in detail the manner in which the well was plugged, indicating where the mud fluid was placed and the method or methods used in introducing it into the hole. If cement or other plugs were used, state the character of same and depth placed, from \_\_\_\_\_ feet to \_\_\_\_\_ feet for each plug set.

Filled hole with mud from 3745 to 200' with plug set at that point and with 20 sacks of cement on plug. Heavy mud to 30' with 10 sacks of cement on top of second plug.

(If additional description is necessary, use BACK of this sheet)

Name of Plugging Contractor Harms-Burt Drilling Company  
Address Box 184, Great Bend, Kansas

STATE OF Kansas, COUNTY OF Barton, ss.  
Allan Harms (employee of owner) or (owner or operator) of the above-described well, being first duly sworn on oath, says: That I have knowledge of the facts, statements, and matters herein contained and the log of the above-described well as filed and that the same are true and correct. So help me God.

(Signature) Allan Harms  
Box 184, Great Bend, Kansas (Address)

SUBSCRIBED AND SWORN TO before me this 2d day of November, 1955

My commission expires 1-20-58

Mary E Van Pelt  
Notary Public.  
STATE CORPORATION COMMISSION

**PLUGGING**  
FILE SEC 21 T 22 R 12 W  
BOOK PAGE 5 LINE 29

NOV 11 1955 11-4-55  
STATE CORPORATION COMMISSION

DRILLERS LOG

Company: Harms Burt Drilling Company

Farm: Neeland #1 NE SE NW 21-~~23~~<sup>22</sup>-14W, Stafford County, Kansas

Commenced: September 20, 1955

Completed: September 30, 1955

Elevation: 1951 RB

0	-	125	sand
125	-	390	shale & shells
390	-	450	sand
450	-	870	red bed & shale
870	-	891	Anhydrite
891	-	1125	shale & shells
1125	-	1600	shale & red bed
1600	-	1700	shale & shells
1700	-	1850	shale & lime
1850	-	2315	lime
2315	-	2475	lime & shale
2475	-	2690	shale with lime streaks
2690	-	3155	shale & lime
3155	-	3365	lime & shale
3365	-	3410	shale & lime
3410	-	3515	shale
3515	-	3745	lime
3745	-		TD

Set 205' 8 5/8" surface pipe. Cemented with 200 sacks posmix; 4 sacks of calcium chloride.

Tops:	Anhydrite	870
	Heebner	3372
	Toronto	3397
	Douglas	3413
	Brown Lime	3505
	Lansing-K.C.	3514
	Base K.C.	3738


Drill Stem Test #1. 3628-3642 - Open 30 min. Recovered 25' of mud with specks of oil, SIP 40# in 20 min. FP 28 to 28.

#2. 3667-3682 - Open 30 min. Recovered 35' of mud. SIP 1210# in 20 min. FP 0 to 18#.

Dry, Plugged &amp; Abandoned.

## AFFIDAVIT:

State of Kansas)  
 )SS.  
 County of BARTON)

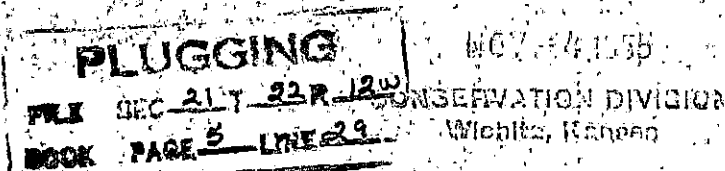

I, Allan Harms of Harms-Burt Drilling Company being first duly sworn on oath state: I have knowledge of the facts, statements, and matters herein contained and the same are true and correct.

Subscribed and sworn to before me this 2 day of November 1955

Comm. Exp. 1-20-58

*Allan Harms*

Mary E Van Pelt  
 Notary Public