


WELL PLUGGING RECORD

Give All Information Completely  
Make Required Affidavit  
Mail or Deliver Report to:  
Conservation Division  
State Corporation Commission  
800 Bittling Building  
Wichita, Kansas

NORTH

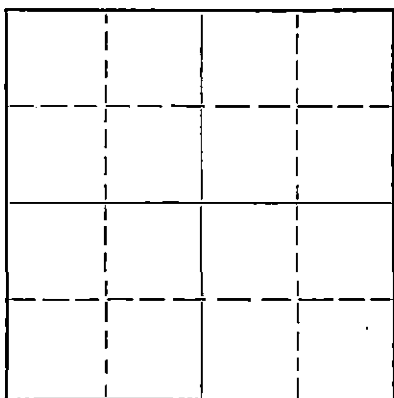

Locate well correctly on above  
Section Plat

Stafford County. Sec. 15 Twp. 22 Rge. 14 (E) W. (W)  
Location as "NE/CNW $\frac{1}{4}$ /SW $\frac{1}{4}$ " or footage from lines 990' W. and 990' S. of Cen.  
Lease Owner Cities Service Oil Company  
Lease Name Smith "N" Well No. 3  
Office Address Bartlesville, Oklahoma  
Character of Well (completed as Oil, Gas or Dry Hole) Dry Hole  
Date well completed May 7 19 53  
Application for plugging filed May 7 19 53  
Application for plugging approved May 7 19 53  
Plugging commenced May 7 19 53  
Plugging completed May 7 19 53  
Reason for abandonment of well or producing formation Dry Hole

If a producing well is abandoned, date of last production 19...  
Was permission obtained from the Conservation Division or its agents before plugging was commenced? Yes

Name of Conservation Agent who supervised plugging of this well M. A. Rives  
Producing formation Depth to top Bottom Total Depth of Well 3710 Feet  
Show depth and thickness of all water, oil and gas formations.

OIL, GAS OR WATER RECORDS

CASING RECORD

Formation	Content	From	To	Size	Put In	Pulled Out
				8-5/8"	402'	None

Describe in detail the manner in which the well was plugged, indicating where the mud fluid was placed and the method or methods used in introducing it into the hole. If cement or other plugs were used, state the character of same and depth placed, from feet to feet for each plug set.

3710-270', heavy mud.  
270-190', wood plug and hull bridge, and 20 sacks cement.  
190-40', mud.  
40' to base of cellar, 10 sacks cement.

5-14-53

(If additional description is necessary, use BACK of this sheet)  
Name of Plugging Contractor Holm Drilling Company  
Address Tulsa, Oklahoma

STATE OF Kansas, COUNTY OF Barton, ss.  
V. M. Conover (employee of owner) or (owner or operator) of the above-described well,

being first duly sworn on oath, says: That I have knowledge of the facts, statements, and matters herein contained and the log of the above-described well as filed and that the same are true and correct. So help me God.

(Signature) *V. M. Conover*  
Box 751, Great Bend, Kansas  
(Address)

SUBSCRIBED AND SWORN TO before me this 11th day of May, 19 53  
*W. E. Smith*  
Notary Public.

My commission expires March 12, 1955.  
23-8390-s 6-51-20M

**PLUGGING**  
FILE SEC 15 T 22 R 14W  
BOOK PAGE 99 LINE 41

# WELL RECORD

Company Cities Service Oil Co. Well No. 3 Farm Smith 498  
 Location 990' South and 990' West of Center Sec. 15 T. 22 R. 14W  
 Elevation 1944 (1941 Cr.) County Stafford State Kansas  
 Drlg. Comm. April 27, 1953 Contractor Holm Drilling Company  
 Drlg. Comp. May 7, 1953 Acid None  
 T. D. 3710' Initial Prod. Dry Hole; P. & A. 5-7-53.

CASING RECORD:

2-5/8" @ 402' cen. 300 sacks cement;  
recem. top 65' w/ 178 sacks.

FORMATION RECORD:

surface soil	0-5
sand	195
shale	265
sand	370
red shale	403
red bed	820
anhydrite	850
shale & shells	1750
lime & shale	2185
shale	2695
shale & lime	2850
lime & shale	3465
lime	3710 T. D.

Heebner	3327'
Brown Limestone	3456'
Lansing	3470'
Base Kansas City	3703'
Total Depth	3710'

Drill Stem Test 3585-96, open  
 1 hr., recovered 14' mud;  
 B. H. P. 0#/15 mins.

Drill Stem Test 3595-3640,  
 open 1 hr., recovered 17'  
 mud; B. H. P. 150#/15 mins.

BYFO:	500'	1°
	1000'	1°
	1500'	1°
	2000'	1°
	2500'	0°
	3000'	1°
	3500'	1°

**PLUGGING**  
 FILE SEC 15 T 22 R 14W  
 BOOK PAGE 99 LINE 41

RECEIVED  
 DIVISION  
 CORP.  
 15.185-12130-1300