


Give All Information Completely
Make Required Affidavit
Mail or Deliver Report to:
Conservation Division
State Corporation Commission
800 Bitting Building
Wichita, Kansas

WELL PLUGGING RECORD

NORTH

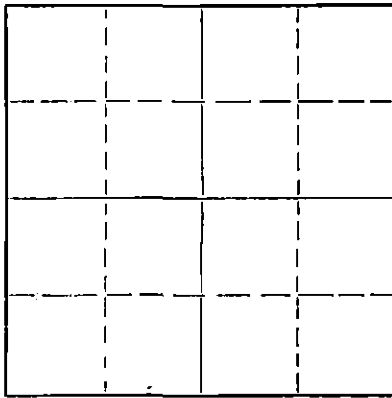

Locate well correctly on above
Section Plat

Stafford County, Sec. 15 Twp. 22 Rge. 11 (E) (W)

Location as "NE/CNW*SW*" or footage from lines SE SE NE

Lease Owner Stearns Petroleum Inc.

Lease Name Gore Well No. 1

Office Address Box 313, Russell, Kansas

Character of Well (completed as Oil, Gas or Dry Hole) Dry

Date well completed 12-11 19 53

Application for plugging filed 2-17 19 54

Application for plugging approved 2-19 19 54

Plugging commenced 2-19 19 54

Plugging completed 2-27 19 54

Reason for abandonment of well or producing formation

If a producing well is abandoned, date of last production 19

Was permission obtained from the Conservation Division or its agents before plugging was commenced? yes

Name of Conservation Agent who supervised plugging of this well Merle Rives

Producing formation Depth to top Bottom Total Depth of Well 3842 Feet

Show depth and thickness of all water, oil and gas formations.

OIL, GAS OR WATER RECORDS

CASING RECORD

FORMATION	CONTENT	FROM	TO	SIZE	PUT IN	PULLED OUT
				8-5/8	372.06	
				5 1/2	3841	2628

Describe in detail the manner in which the well was plugged, indicating where the mud fluid was placed and the method or methods used in introducing it into the hole. If cement or other plugs were used, state the character of same and depth placed, from _____ feet to _____ feet for each plug set.

Lane Wells plug @ 3520'. Sand
to 3468' Dumped 5 sacks cement.
Pulled 2628' 5 1/2 O.D. casing. Squeezed
23 sacks jel mud and 100 sacks cement
thru 8-5/8'

(If additional description is necessary, use BACK of this sheet)

Name of Plugging Contractor Barnes & Sons

Address Russell, Kansas

STATE OF Kansas COUNTY OF Russell, ss.

(Signature) (employee of owner) or (owner or operator) of the above-described well, being first duly sworn on oath, says: That I have knowledge of the facts, statements, and matters herein contained and the log of the above-described well as filed and that the same are true and correct. So help me God.

(Signature)


(Address)

SUBSCRIBED AND SWORN TO before me this 1 day of March, 19 54

My commission expires March 3, 1957

(Signature) Notary Public.

24-2675-9 2-52-20M

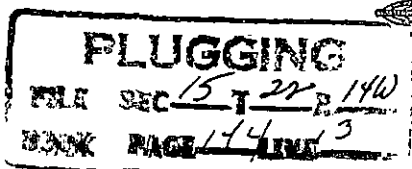

3-3-54

GORE #1

Operator: Stearns Petroleum, Inc.
 Contractor: Stearns Petroleum, Inc.
 Commencement Date: November 6, 1953
 Completion Date: November 19, 1953

Location: SE SE NE
 Section 15-22-14,
 Stafford County, Kansas

Casing Record:

8 5/8" 372.06' Cemented with 395 sacks.
 5 1/2" 3872.52' Cemented with 200 sacks.

- WELL LOG -

Cellar	0	40
Lime, Sand and Shale	40	150
Lime and Shale	150	370
Red Bed and Shale	370	845
Anhydrite	845	875
Shale and Shells	875	1350
Salt and Shale	1350	1445
Shale and Shells	1445	1650
Lime and Shale	1650	3609
Lime	3609	3735
Conglomerate	3735	3737
Viola	3737	3785
Simpson	3785	3842
Total Depth:	3842	

STATE OF KANSAS)
) SS:
 COUNTY OF RUSSELL)

I hereby certify that the above information is true and correct to the best of my knowledge.

Harold Hebonck

SUBSCRIBED AND SWORN TO before me, a Notary Public, this 8th day of January, 1954.

Zeta Dennis
 Notary Public

My Commission Expires:

March 3, 1957

PLUGGING
 FILE SEC 15-22-14W
 BOOK PAGE 14 LINE 13